

COMMISSION

1993 NEWAYGO COUNTY REMONUMENTATION PROJECT OF DEEDS

MARLENE TOOGOOD

LAND CORNER RECORDATION CERTIFICATE

Filing Requirement of Act 74, Mich. P.A. 1970

84 JAN 21 PM 3 27

For corners in Newaygo (County)

Table with columns: Located In, Corner Code #. Row 1: T 14N R 14W, AL

Marlene Toogood VOL 001 PAGE 35

Register of Deeds Stamp & File Number

- 4. Lot No. Recorded Plat
5. Private Claims

Grid table with columns A-K and rows 1-13. Cell (1,1) contains a dot.

I, Norman L. Ochs, in a field survey on December 17, 1993, do hereby certify that under requirements of P.A. 74, Michigan P.A. of 1970, the corner points mentioned in lines 1 and 2 above were in conformance with regulations and rules therefore as required in the current manual of survey instructions of the United States Department of the Interior, Bureau of Land Management or by a decree of a Court of Law and/or that the corner points mentioned in lines 3, 4 and 5 above were in conformance with the rules of the Michigan Board of Land Surveyors or by a Decree of a Court of Law; established, re-established, monumented, re-monumented, recovered, found as expressed below:

NOTE: Not more than 4 corners, all in the same town and range, may be recorded on this certificate. A1 NW Corner, Section 6, Denver Twp.

A. Description of original monument and accessories and/or subsequent restoration: G.L.O. Delos Anderson, Aug. 16-18, 1899 Fnd. old corner of Gov't survey. (no accessories given) N40W 12" Beech 67 lks. S80°E 12" Beech 30 lks. NCRC Sheet N86E Pine Stp. 52.8' S55E 18" Elm 28.8' Newaygo County Road Commission Corner Card File (No date provided) 1-1/4" Pipe N56E 30" Elm 42.5' S45E 12" Walnut 49.3'

Lyle Shepherd's Book N89 25 E 18" Pine Stp. 80' N42W 24" Pine Stp. 62' Oceana County Road Commission Corner Card File, Well Point-Blue Stone on Top S55E 14" Twin Oak 40.2' S80E 15" Elm 62.7' N35E 24" Pine Stp. 52.9'

B. Description of corner evidence found and/or method applied in restoring or reestablishing corner: N. L. Ochs, RLS #22439 December 17, 1993, Fnd. 1" OD x 18" Pinch Pipe inside a 1-3/4" od x 40" pipe. Replaced Pipes with a 2-3/4" x 30" cast iron marker.


C. Description of monument for corner and accessories established to perpetuate locating the position of the corner: Set a 4" Harrison Cast Iron Marker as a substantial marker for the Section corner, and is accepted as a careful and faithful re-establishment of the position of the original corner.

- 4" Cast Iron Marker
AZ 35° 14" Oak 44.74'
AZ 89° Metal Fe Post 32.27' 1" above grade
AZ 90° 3/4" pipe at road R/W 33.04'
AZ 127° 20" & 16" Oak 40.53'
AZ 263° 14"-16"-16" Oak Clump 137.87'

NIR; Nail driven in vertically into exposed tree root. Azimuths are shown above.

Signed by Norman L. Ochs Date December 27, 1993

Surveyor's Michigan License No. 22439 Approved by Peer Review Group on December 27, 1993 Norman L. Ochs, County Representative

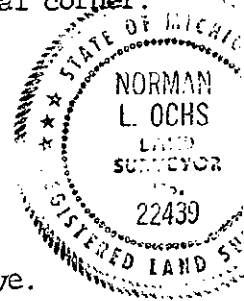

A cont. . .

1973 P.A.S. LS 13594
3/4" Pinch Pipe, Rec'd Jckt 315
S58° 20" Twin R. Oak 40.66'
S82E 10" Maple 53.64'
East Cor. Fe Post 28.8'
East Iron Pipe 33.02'

Newaygo Eng. & Survey Co.
1" Pipe over well point
N86E Pine Stp. 52.8'
S55E 18" Elm 28.8'
S65E 10" Oak 39.8'
S80E 10" Clp. Maple 53.2'

1989 Wm. Fries, Jr., LS 30389
Fnd. 1" OD Pipe, Recorded
Corner Form 841
AZ 90 3/4" Pipe 33.04'
AZ 35 14" Oak 44.75'
AZ 89 Metal Fe Post 31.37'
AZ 127 16"-20" Tw Oak 40.53'
AZ 263 14"-16"-16" Tri-Oak
137.87'