

SURVEY & REMONUMENTATION

MAR 19 1998

1997 Newaygo County Remonumentation Project

NEWAYGO COUNTY REGISTER OF DEEDS LINDA M. BROWN

'98 MAR 6 PM 12 31

SECTION

LAND CORNER RECORDATION CERTIFICATE FILING REQUIREMENT of Act 74, Mich. P.A. 1970

Linda M. Brown

For corners in
Newaygo
 (County)

Located in: _____ Corner Code # _____

1. Public Land Survey T 14N R 14W E-9
 T _____ R _____
 T _____ R _____
 T _____ R _____

2. Property Controlling in Section S _____ T _____ R _____
 S _____ T _____ R _____

3. Miscellaneous Property in Sec. S _____ T _____ R _____
 S _____ T _____ R _____

4. Lot No. _____, Recorded Plat _____

5. Private Claims _____

VOL. 2

99

Register of Deeds Stamp & File Number

	A	B	C	D	E	F	G	H	I	J	K	L	M
1													
2	6	5	4	3	2	1							
3													
4	7	8	9	10	11	12							
5													
6	18	17	16	15	14	13							
7													
8	19	20	21	22	23	24							
9													
10	30	29	28	27	26	25							
11													
12	31	32	33	34	35	36							
13													

I, Norman L. Ochs, in a field survey on October 2, 1997, do hereby certify that under requirements of P. A. 74, Michigan P.A. of 1970, the corner points mentioned in lines 1 and 2 above were in conformance with regulations and rules therefore as required in the current manual of survey instructions of the United States Department of the Interior, Bureau of Land Management or by a decree of a Court of Law and/or that the corner points mentioned in lines 3, 4 and 5 above were in conformance with the rules of the Michigan Board of Land Surveyors or by a Decree of a Court of Law; established, re-established, monumented, re-monumented, recovered, found as expressed below.

Note: Not more than 4 corners, all in the same town and range, may be recorded on this certificate.

Northwest Corner, Section 28, Denver Township, Newaygo County, Michigan.

A. DESCRIPTION OF ORIGINAL MONUMENT AND ACCESSORIES AND/OR SUBSEQUENT RESTORATION:

G.L.O. Milton Nye and Brookfield and Mullett Resurvey 1857
 20" Cedar S42½°E 35 Links (23.10') #1
 18" Cedar N11°W 10 Links (6.60') #2
 12" Maple N67°E 18 Links (11.88') #3

George Blass R.L.S. #5489
 Consumers Power Company Section Break 1968
 Drawing Number S-F17051
 10" Cedar S11°E 11.97' #4
 8" Birch N40°E 36.75' #5
 6" Cedar N32°W 17.36' #6

George J. Mitchell R.L.S. #19618
 September 22, 1995
 Recorded in Liber 362 Page 3012 thru 3019
 "White River" Survey
 Found ½" Pipe in North and South fence line
 6" Cedar S35°E 19.33' #7
 4" Elm S85°W 9.70' #8
 8" Cedar N06°E 25.32' #9
 4" Elm N38°E 15.80' #10
 Cedar Stump West 0.80' #11

OVER ↵

B. DESCRIPTION OF CORNER EVIDENCE FOUND AND/OR METHOD APPLIED IN RESTORING OR REESTABLISHING CORNER:

Found ½" x 14" Iron-Pipe. Found remnants of North and South fence line 200 feet South. Corner is in swamp. No other occupation. The condition of the recorded witnesses are: #1 thru #3 gone, #4 fallen, #5 and #6 gone, #7 good condition, #8 dead, #9 good condition, #10 dead, #11 stump.

C. DESCRIPTION OF MONUMENT FOR CORNER AND ACCESSORIES ESTABLISHED TO PERPETUATE LOCATING THE POSITION OF THE CORNER:

Removed ½" X 14" Iron Pipe and set a 4" diameter Harrison cast iron monument 36" long marked "County Surveyor" as a substantial marker for the section corner and is accepted as a careful and faithful reestablishment of the original corner.

8" Hemlock S45°E 19.33' Found small nail in Southwesterly side of tree, Set spike and brass washer next to small nail. #6
 4" Elm (dead) S85°W 9.65' Found small nail in South side of tree. #7
 6" Cedar N10°E 25.28' Set spike and brass washer next to found small nail in West side of tree. #8
 4" Elm (dead) N47°E 15.72' Found small nail in Northwesterly side of tree. #9
 Stump West 0.80' to centerline. #10
 6" Cedar N50°E 36.98' Set spike and brass washer in Northwest side of tree.
 8" Cedar S40°W 36.55' Set spike and brass washer in Southeasterly side of tree.


Signed by Norman L. Ochs Date October 7, 1997

Surveyor's Michigan License No. 22439


Approved by Peer Review Group on October 14, 1997
 Norman L. Ochs, County Representative.

N.L.O.

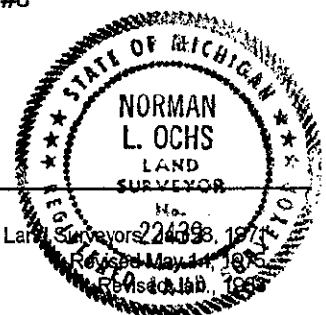

A. Description (cont.)

Patrick A. Salisbury R.L.S. #13594

Drawing Number 73107B July 13, 1973

Found $\frac{3}{4}$ " Iron by fence corner

10" Cedar S10°E 11.94' #4

10" Yellow Birch N50°E 36.70' #5