

1993

1993 NEWAYGO COUNTY REMONUMENTATION PROJECT

STATE OF MICHIGAN
REGISTER OF DEEDS
MARLENE TOOGOOD

COMMISSION

LAND CORNER RECORDATION CERTIFICATE

Filing Requirement of Act 74, Mich. P.A. 1970' 94 JAN 21 PM 3 28

For corners in

<u>NEWAYGO</u> (County)	Located In:	Corner Code #
1. Public Land Survey	T <u>15N</u> R <u>11W</u>	<u>A-3</u>
	T ___ R ___	_____
	T ___ R ___	_____
	T ___ R ___	_____
2. Property Controlling in Section	S ___ T ___ R ___	_____
	S ___ T ___ R ___	_____
3. Miscellaneous Property in Sec.	S ___ T ___ R ___	_____
	S ___ T ___ R ___	_____

Marlene Toogood

VOL **001** PAGE **54**

Register of Deeds Stamp & File Number

- 4. Lot No. _____, Recorded Plat _____
- 5. Private Claims _____

A	B	C	D	E	F	G	H	I	J	K	L
2	6	5	4	3	2	1					
3	7	8	9	10	11	12					
4											
5											
6	18	17	16	15	14	13					
7											
8	19	20	21	22	23	24					
9											
10	30	29	28	27	26	25					
11											
12	31	32	33	34	35	36					
13											

I, Norman L. Ochs, in a field survey on December 7, 1993, do hereby certify that under requirements of P.A. 74, Michigan P.A. of 1970, the corner points mentioned in lines 1 and 2 above were in conformance with regulations and rules therefore as required in the current manual of survey instructions of the United States Department of the Interior, Bureau of Land Management or by a decree of a Court of Law and/or that the corner points mentioned in lines 3, 4 and 5 above were in conformance with the rules of the Michigan Board of Land Surveyors or by a Decree of a Court of Law; established, re-established, monumented, re-monumented, recovered, found as expressed below.

NOTE: Not more than 4 corners, all in the same town and range, may be recorded on this certificate.

SW. Corner, Section 6, Norwich Twp., Newaygo Co., Mich.

A. Description of original monument and accessories and/or subsequent restoration:

G.L.O. 1856 Milton Nye
7" Hemlock N65°E 261ks. (17.16') #1
16" W. Pine S67 1/2°E 28 1ks. (18.48') #2

Lyle S. Shepherd R.L.S. #503
Sept. 6, 1916 Book 36 Page 93
Found Old Stake
16" Pine Stump S76°E 36 1/4' #7
4" Pine Stump S55 1/4°E 48 3/4' #6
24" Pine Stump N23 1/2°W 35 3/4' #
30" Pine Stump S61 1/2°W 34' #4

Delos G. Anderson Aug. 26, 1898
Book A Page 229 and 230
Found spoked wheel.
16" Pine Stump N03°W 251ks. (16.5') #3
36" Pine Stump S58 1/2°W 521ks. (34.32') #4
30" Pine Stump N23 1/2°W 541ks. (35.64') #5

SEE OVER-----

B. Description of corner evidence found and/or methods applied in restoring or reestablishing corner:

In 1898 Delos G. Anderson located corner and located witnesses. In 1916 Lyle S. Shepherd found old stake and located 2 witnesses of Andersons. In 1975 Robert A. Griffin found broken buggy axle.


C Found broke buggy axle. Replaced with 4" Harrison Cast Iron Monument.

Condition of recorded witnesses is: #1 thru #9 Gone on Dec. 07, 1993.

C. Description of monument for corner and accessories established to perpetuate locating the position of the corner:

Accepted 4" Harrison Cast Iron Monument as a substantial marker for the section corner and is accepted as a careful and faithful reestablishment of the original corner.

18" R. Pine S80°E 103.43' Spike in North side of tree
15" R. Pine S45°E 103.51' Spike in SW. side of tree
10" R. Pine S40°W 98.00' Spike in NW. side of tree
4"x4" Post S06°W 97.76' Nail in East side of post

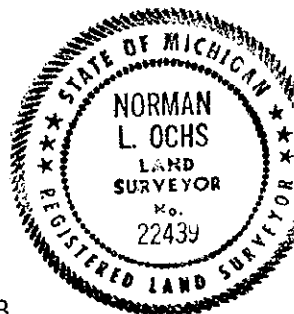

Signed by Norman L. Ochs
Norman L. Ochs 22439

Date December 28, 1993

Surveyor's Michigan License No. _____
Approved by Peer Group December 29, 1993
Norman L. Ochs, County Representative

A. Continued.....

Robert A. Griffin R.L.S. #13584

April 15, 1975

Found broken buggy axle (12" long)

U.S.G.S. BM. S52°W 41.93' #8

Fence Corner Post S27°W 76.42' #9

U.S.G.S. ...
U.S.G.S. ...