

MAR 02 1993

1998 Newaygo County Remonumentation Project

NEWAYGO COUNTY REGISTER OF DEEDS
LINDA M. BROWN

**LAND CORNER RECORDATION CERTIFICATE
FILING REQUIREMENT of Act 74, Mich. P.A. 1970**

99 FEB 17 PM 3 43

SECTION

For corners in <u>Newaygo</u> (County)	Located in:	Corner Code #
1. Public Land Survey	T <u>15N</u> R <u>11W</u>	<u>I-6</u>
	T _____ R _____	_____
	T _____ R _____	_____
	T _____ R _____	_____
2. Property Controlling in Section	S _____ T _____ R _____	_____
	S _____ T _____ R _____	_____
3. Miscellaneous Property in Sec.	S _____ T _____ R _____	_____
	S _____ T _____ R _____	_____
4. Lot No. _____, Recorded Plat _____		
5. Private Claims _____		

Linda M. Brown

VOL. 2

272

Register of Deeds Stamp & File Number

	A	B	C	D	E	F	G	H	I	J	K	L	M
1													
2	6		5		4		3		2		1		
3													
4	7		8		9		10		11		12		
5													
6	18		17		16		15		14		13		
7													
8	19		20		21		22		23		24		
9													
10	30		29		28		27		26		25		
11													
12	31		32		33		34		35		36		
13													

I, Norman L. Ochs, in a field survey on December 16, 1998, do hereby certify that under requirements of P. A. 74, Michigan P.A. of 1970, the corner points mentioned in lines 1 and 2 above were in conformance with regulations and rules therefore as required in the current manual of survey instructions of the United States Department of the Interior, Bureau of Land Management or by a decree of a Court of Law and/or that the corner points mentioned in lines 3, 4 and 5 above were in conformance with the rules of the Michigan Board of Land Surveyors or by a Decree of a Court of Law; established, re-established, monumented, re-monumented, recovered, found as expressed below.

Note: Not more than 4 corners, all in the same town and range, may be recorded on this certificate.

East One Quarter Corner, Section 15, Norwich Township, Newaygo County, Michigan.

A. DESCRIPTION OF ORIGINAL MONUMENT AND ACCESSORIES AND/OR SUBSEQUENT RESTORATION:

G.L.O: Milton Nye 1856 Resurvey
12" Beech S50°W 6 Links (3.96') #1
12" Beech S46°E 21 Links (13.86') #2

Ralph A. Smith R.L.S. 33421
Book 83, Page 53 1956
Set a 3/4" Gas Pipe
6" White Oak N45°E 35.2' #3
10" Maple N30°E 29.4' #4

Ralph A. Smith R.L.S. #3421
1950's Undated survey
Found 4" Concrete Monument 3 feet long
6" White Oak N45°E 35.2' #3
10" Maple N30°E 29.4' #4

Robert A. Griffin R.L.S. #13584
LCRC #109 July 24, 1962 Found 4" Round by 3' long concrete with 5/8" Iron rod cast full length in the center of the monument and both witness trees as called for in the notes of Ralph Smith R.L.S. #3421
7" White oak N52°W 35.60' #3
12" Maple N32°W 29.85' #4
7" Maple S44°E 86.75' #5
4" Maple S46°W 9.65' #6
5" X 7' Cedar Post West 1.4' #7

OVER 6

B. DESCRIPTION OF CORNER EVIDENCE FOUND AND/OR METHOD APPLIED IN RESTORING OR REESTABLISHING CORNER:

Found 4" concrete monument 0.6 feet above ground. There is a single strand wire fence going North and East. The condition of the recorded witnesses are: #1 thru #2 gone, #3 good condition, #4 gone, #5 thru #8 good condition.

C. DESCRIPTION OF MONUMENT FOR CORNER AND ACCESSORIES ESTABLISHED TO PERPETUATE LOCATING THE POSITION OF THE CORNER:

Accepted 4" concrete monument as a substantial marker for the section corner and is accepted as a careful and faithful reestablishment of the original corner.

12" White Oak (blazed) N58°E 35.65' Found spike in Southeasterly side of tree. #3
14" Maple (blazed) S35°E 86.67' Found spike in Northeasterly side of tree. #5
14" Maple (blazed) S54°W 9.70' Found square spike in Northwesterly side of tree. #6
5" X 7' Cedar Post West 1.4' #7
Centerline of Railroad grade South 180' #8


Signed by Norman L. Ochs Date December 18, 1998

Surveyor's Michigan License No. 22439

Form approved by Michigan State Board of Land Surveyors Jan 28, 1997

Approved by Peer Review Group on December 22, 1998
Norman L. Ochs, County Representative.

N.L.O.

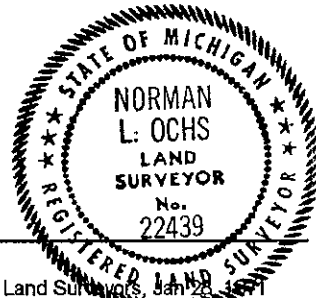

Revised May 14, 1975
Revised Jan., 1983

A. Description (cont.)

Patrick A. Salisbury R.L.S. #13594
June 21, 1972 Found monument and fence post
Centerline of Railroad South 180' #8
8" White Oak N52°E 35.73' #3
10" - 6" Twin Maple N32°W 29.26' #4
6" Maple S46°W 9.69' #6

Norman L. Ochs R.L.S. #22439
October 30, 1978
7" Maple S44°E 86.36' #5
4" Maple S46°W 9.69' #6
Cedar Post West 1.4' #7
8" White Oak N52°E 35.61' #3
10" - 6" Twin Maple N32°W 29.72' #4

Norman L. Ochs R.L.S. #22439
April 25, 1991 Drawing Number 91054B
8" White Oak N52°E 35.61' #3
10" - 6" Twin Maple N32°W 29.26' #4
6" Maple S46°W 9.69' #6

Norman L. Ochs R.L.S. #22439
April 24, 1997 Drawing Number 97084B
Found concrete monument
12" Maple S53°W 9.70' #6
Cedar Post West 1.40' #7
12" Maple S35°E 86.65' #5
12" White Oak N59°E 35.85' #3

SURVEY &
REMONUMENTATION

MAR 02 1999

SECTION