

SURVEY & REMONUMENTATION

MAR 19 1998

1997 Newaygo County Remonumentation Project

NEWAYGO COUNTY REGISTER OF DEEDS LINDA H. BROWN

'98 MAR 6 PM 12 31

SECTION

LAND CORNER RECORDATION CERTIFICATE FILING REQUIREMENT of Act 74, Mich. P.A. 1970

Linda M. Brown

For corners in Newaygo (County) Located in: Corner Code #

1. Public Land Survey T 15N R 11W M-3
 T ___ R ___
 T ___ R ___
 T ___ R ___

2. Property Controlling in Section S ___ T ___ R ___
 S ___ T ___ R ___

3. Miscellaneous Property in Sec. S ___ T ___ R ___
 S ___ T ___ R ___

VOL. 2

139

4. Lot No. _____, Recorded Plat _____
 5. Private Claims _____

Register of Deeds Stamp & File Number

	A	B	C	D	E	F	G	H	I	J	K	L	M
1													
2	6		5		4		3		2		1		
3													
4	7		8		9		10		11		12		
5													
6	18		17		16		15		14		13		
7													
8	19		20		21		22		23		24		
9													
10	30		29		28		27		26		25		
11													
12	31		32		33		34		35		36		
13													

I, Norman L. Ochs, in a field survey on October 4, 1997, do hereby certify that under requirements of P. A. 74, Michigan P.A. of 1970, the corner points mentioned in lines 1 and 2 above were in conformance with regulations and rules therefore as required in the current manual of survey instructions of the United States Department of the Interior, Bureau of Land Management or by a decree of a Court of Law and/or that the corner points mentioned in lines 3, 4 and 5 above were in conformance with the rules of the Michigan Board of Land Surveyors or by a Decree of a Court of Law; established, re-established, monumented, re-monumented, recovered, found as expressed below:

Note: Not more than 4 corners, all in the same town and range, may be recorded on this certificate.

Northeast Corner, Section 12, Norwich Township, Newaygo County, Michigan.

A. DESCRIPTION OF ORIGINAL MONUMENT AND ACCESSORIES AND/OR SUBSEQUENT RESTORATION:

G.L.O. Milton Nye 1856 Resurvey
 8" Beech S23°W 19 Links (12.54') #1
 18" Beech N09°W 51 Links (33.66') #2

William M. Jacques (County Surveyor)
 Book B Pages 36 and 37 September 12, 1908
 Stone with broken glass around.

Newaygo County Road Commission Sheet
 Large Spike
 Fence Post S15°W 46.65' #3
 Fence Post N40°E 48.10' #6
 North end of Corrugated Metal Pipe N45°W 33.0' #7
 1" Pipe N20°W 95.76' #8

Robert A. Griffin R.L.S. #13584
 1975 Found Truck Spring at road intersection (raised it to surface with 10" dock spike)
 Fence Post S42°W 46.65' #3
 "X" Cut in top center Stone 3.1' X 2.5' X 2.0' N26°W 87.78' #4

Ferris State University Students 1977
 Pine N40°W 111.33' #5
 Fence Post N30°E 48.30' #6
 Fence Post S42°W 46.65' #3

OVER ↵

B. DESCRIPTION OF CORNER EVIDENCE FOUND AND/OR METHOD APPLIED IN RESTORING OR REESTABLISHING CORNER:

Found 6" Spike in 1" X 10" Iron Pipe over a 10" Dock Spike. Detected metal still in hole. The centerline of the East and West road is 2.5 feet North and in the centerline of the North and South gravel road. The condition of the recorded witnesses are: #1 and #2 gone, #3 Found, but the original wood fence Wood Post was replaced with 5" steel fence post filled with concrete as told to me by Floyd Dickson, owner of the fence, #4 found, but stone has been moved, #5 good condition, #6 gone, #7 good condition, #8 found pipe laying nearby.

C. DESCRIPTION OF MONUMENT FOR CORNER AND ACCESSORIES ESTABLISHED TO PERPETUATE LOCATING THE POSITION OF THE CORNER:

Removed Spikes and Iron Pipe and set a 4" diameter Harrison cast iron monument 20" long marked "County Surveyor" over metal in hole, as a substantial marker for the section corner and is accepted as a careful and faithful reestablishment of the original corner.

5" Steel Fence Post filled with concrete S40°W 46.60' Replaced R.A.G. tag. #3
 "X" Cut in top center Stone 2.0' X 2.5' X 4' N60°W 76.82' (±33' North of section line) #4
 14" Red Pine N30°W 111.28' Set spike and tag in Southwest side of tree. #5
 Corrugated Metal Pipe N47°W 32.72' bent at North end. #7
 Power Pole S67°E 168.40' Found spike in North side of pole. #9
 16" Cherry N54°E 95.90' Set spike and brass washer #22439 (blazed) on Northwest side.

Signed by Norman L. Ochs
 Norman L. Ochs

Date October 7, 1997

Surveyor's Michigan License No. 22439


Form approved by Michigan State Board of Land Surveyors, Jan 28, 1971

Approved by Peer Review Group on November 11, 1997

Revised May 14, 1975

Norman L. Ochs, County Representative.

Revised Jan., 1983

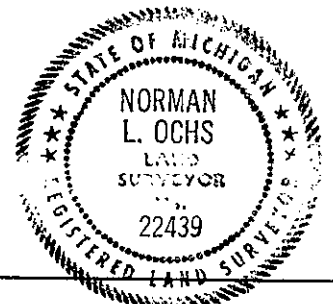

MLO

A. Description (cont.)

Gerald J. Gray R.L.S. #17741
Liber 11 Page 180 September 15, 1985 ¾" Pipe
4" Pine N40°W 111.33' #5
Fence Post N30°E 48.30' #6
Fence Post S42°W 46.65' #3