

1993 NEWAYGO COUNTY REMONUMENTATION PROJECT

NEWAYGO COUNTY
REGISTER OF DEEDS
MARLENE TOOGOOD

1993

'94 JAN 21 PM 3 28

COMMISSION

LAND CORNER RECORDATION CERTIFICATE
Filing Requirement of Act 74, Mich. P.A. 1970

Marlene Toogood

For corners in

NEWAYGO

(County)

Located In:

Corner Code #/

- | | | |
|------------------------------------|---------------------------|------------|
| 1. Public Land Survey | T <u>15N</u> R <u>12W</u> | <u>A-2</u> |
| | T _____ R _____ | _____ |
| | T _____ R _____ | _____ |
| | T _____ R _____ | _____ |
| 2. Property Controlling in Section | S _____ T _____ R _____ | _____ |
| | S _____ T _____ R _____ | _____ |
| 3. Miscellaneous Property in Sec. | S _____ T _____ R _____ | _____ |
| | S _____ T _____ R _____ | _____ |

VOL 001 PAGE 52

Register of Deeds Stamp & File Number

4. Lot No. _____, Recorded Plat _____
5. Private Claims _____

I, Norman L. Ochs, in a field survey on November 1, 19 93, do hereby certify that under requirements of P.A. 74, Michigan P.A. of 1970, the corner points mentioned in lines 1 and 2 above were in conformance with regulations and rules therefore as required in the current manual of survey instructions of the United States Department of the Interior, Bureau of Land Management or by a decree of a Court of Law and/or that the corner points mentioned in lines 3, 4 and 5 above were in conformance with the rules of the Michigan Board of Land Surveyors or by a Decree of a Court of Law; established, re-established, monumented, re-monumented, recovered, found as expressed below:

	A	B	C	D	E	F	G	H	I	J	K	L	M
2	6	5	4	3	2	1							
3													
4	7	8	9	10	11	12							
5													
6	18	17	16	15	14	13							
7													
8	19	20	21	22	23	24							
9													
10	30	29	28	27	26	25							
11													
12	31	32	33	34	35	36							

NOTE: Not more than 4 corners, all in the same town and range, may be recorded on this certificate.

West 1/4 Corner, Section 6, Monroe Twp., Newaygo County

A. Description of original monument and accessories and/or subsequent restoration: MI

- | | | |
|-----------------------------|--------------------------------------|----------------------------|
| G.L.O. 1837 John Hodgson | 7-25-67 Robert A Griffin | 4-26-84 N. E. & S. Co. |
| 18" Pine N46°W 70 lks #1 | Set 5" sq. conc. mon. | Fnd. 5" sq. conc. mon. |
| 18" Pine S57°W 19 lks #2 | 7" B. Oak N31°E 68.79' #4 | 7" B. Oak N31°E 68.79' #10 |
| Monument Post | 25" B. Oak N43°E 48.8' #5 | 25" B. Oak N43°E 48.8' #11 |
| 1935 R E Mathews U.S.F.S. | 4" W. Pine S53°E 87.79' #6 | 5" B. Oak S61°W 52.16' #12 |
| Mon. - Iron Pipe - Fnd. | 4" Sq. x 7' Pine Post S45°E 46.7' #7 | 5" W. Oak N44°W 83.42' #13 |
| 18" B. Oak N43°E 74 lks. #3 | 5" B. Oak S61°W 52.16' #8 | |
| (48.84') | 5" W. Oak N44°W 83.42' #9 | |

B. Description of corner evidence found and/or method applied in restoring or reestablishing corner:


Found Griffins 5" sq. conc. monument. He found pipe & witness from 1935. See LCRC #114.

Condition of recorded witnesses is: #1 gone, #2 gone, #3 good condition, #4 good condition, #5 good condition, #6 good condition, #7 gone, #8 good condition, #9 good condition, #10 good condition, #11 good condition, #12 good condition, #13 good condition.

C. Description of monument for corner and accessories established to perpetuate locating the position of the corner:

Accepted R. A. Griffins 5" sq. conc. monument as a substantial marker for the 1/4 corner and is accepted as a careful and faithful reestablishment of the position of the original corner.

- 12" B. Oak N31°E 68.83' (Spike in West side of tree) #4, #10.
- 30" B. Oak N43°E 48.77' (Spike in SE side of tree) #3, #5, #11.
- 8" W. Pine S53°E 84.89' (Spike in NE side of tree) #6.
- 12" B. Oak S61°W 58.18' (Spike in East side of tree) #8, #12.
- 8" W. Oak N44°W 83.52' (Spike in NE side of tree) #9, #13.

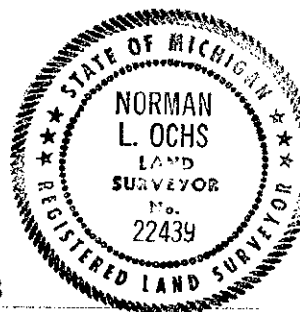

Signed by Norman L. Ochs
Surveyor's Michigan License No. 22439

Date November 8, 1993

Approved by Peer Review Group Nov. 9, 1993
Norman L. Ochs, County Representative