

SURVEY & REMONUMENTATION

MAR 19 1998

1997 Newaygo County Remonumentation Project

NEWAYGO COUNTY REGISTER OF DEEDS LINDA M. BROWN

'98 MAR 6 PM 12 38

LAND CORNER RECORDATION CERTIFICATE FILING REQUIREMENT of Act 74, Mich. P.A. 1970

SECTION

For corners in Newaygo (County) Located in: _____ Corner Code # _____

1. Public Land Survey T 15N R 12W D-5
 T _____ R _____
 T _____ R _____
 T _____ R _____

2. Property Controlling S _____ T _____ R _____
 in Section S _____ T _____ R _____

3. Miscellaneous S _____ T _____ R _____
 Property in Sec. S _____ T _____ R _____

4. Lot No. _____, Recorded Plat _____

5. Private Claims _____

Linda M. Brown

VOL. 2 134

Register of Deeds Stamp & File Number

	A	B	C	D	E	F	G	H	I	J	K	L	M
1													
2	6	5	4	3	2	1							
3													
4	7	8	9	10	11	12							
5													
6	18	17	16	15	14	13							
7													
8	19	20	21	22	23	24							
9													
10	30	29	28	27	26	25							
11													
12	31	32	33	34	35	36							
13													

I, Norman L. Ochs, in a field survey on October 3, 1997, do hereby certify that under requirements of P. A. 74, Michigan P.A. of 1970, the corner points mentioned in lines 1 and 2 above were in conformance with regulations and rules therefore as required in the current manual of survey instructions of the United States Department of the Interior, Bureau of Land Management or by a decree of a Court of Law and/or that the corner points mentioned in lines 3, 4 and 5 above were in conformance with the rules of the Michigan Board of Land Surveyors or by a Decree of a Court of Law, established, re-established, monumented, re-monumented, recovered, found as expressed below:

Note: Not more than 4 corners, all in the same town and range, may be recorded on this certificate.

North One Quarter Corner, Section 17, Monroe Township, Newaygo County, Michigan.

A. DESCRIPTION OF ORIGINAL MONUMENT AND ACCESSORIES AND/OR SUBSEQUENT RESTORATION:

G.L.O. Milton Nye Resurvey 1856
 6" Spruce Pine N34°E 25 Links (16.5') #1
 14" Yellow Pine S80°W 23 Links (15.18') #2

Newaygo County Road Commission Sheet
 10" Pine S42°E 20.46' #3
 6" Pine S29°W 18.48' #4

Delos G. Anderson (County Surveyor)
 Book A Pages 207 and 208 August 3 to 5, 1897
 10" Pine S42°E 31 Links (20.46') #3
 6" Pine S29°W 28 Links (18.48') #4

Patrick A. Salisbury R.L.S. #13594
 1972 Set 5" X 5" X 5' Concrete Monument with brass cap.
 14" Black Oak N28°E 3.25' #5
 14" Black Oak S72°W 37.84' #6
 16" Black Oak N89°E 39.84' #7
 8" Black Oak S01°W 36.86' #8

OVER ↙

B. DESCRIPTION OF CORNER EVIDENCE FOUND AND/OR METHOD APPLIED IN RESTORING OR REESTABLISHING CORNER:

Found concrete monument with brass cap #13594 one foot above ground. The South edge of pine plantation is 32 feet South. Fence corner to single wire South and West fence (on ground) is 3.5 feet North and 2 feet East. The condition of the recorded witnesses are: #1 thru #4 gone, #5 and #6 good condition, #7 stump, #8 good condition, #9 gone, #10 good condition.

C. DESCRIPTION OF MONUMENT FOR CORNER AND ACCESSORIES ESTABLISHED TO PERPETUATE LOCATING THE POSITION OF THE CORNER:


Accepted concrete monument with brass cap as a substantial marker for the section corner and is accepted as a careful and faithful reestablishment of the original corner.

20" Black Oak N32°E 3.27' Found and reset new spike and tag in North side of tree. #5
 20" Black Oak S75°W 37.78' Found spike in North side of tree. #6
 Stump N88°E 39.84' top center. #7
 14" Black Oak S03°W 36.84' Found and reset new spike and tag in West side of tree. #8
 1/2" Rerod S85°W 165.23' #10
 26" Black Oak S75°E 72.94' Set spike and tag in North side of tree.

Signed by Norman L. Ochs Date October 7, 1997
 Norman L. Ochs

Surveyor's Michigan License No. 22439 Form approved by Michigan State Board of Land Surveyors, Jan 28, 1971

Approved by Peer Review Group on November 11, 1997
 Norman L. Ochs, County Representative.

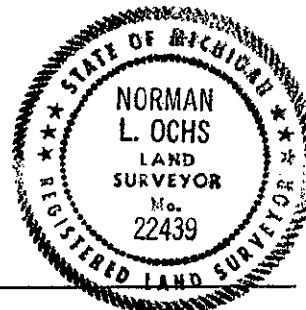

Revised May 14, 1975
 Revised Jan., 1983

N.L.O.

A. Description (cont.)

William Fries, Jr. R.L.S. #30389

LCRC #1037 October 24, 1990

Found Concrete Monument

14" Black Oak N28°E 3.25' #5

14" Black Oak S72°W 37.84' #6

8" Black Oak S01°W 36.86' #8

Nail and tag in ground S13°E 36.16' #9

½" Iron West 165.16' #10