

APR 04 1996

1995 Newaygo County Remonumentation Project

COMMISSION

LAND CORNER RECORDATION CERTIFICATE FILING REQUIREMENT of Act 74, Mich. P.A. 1970

VOL. 1 PAGE 199

NEWAYGO COUNTY REGISTER OF DEEDS

1995 FEB 21 AM 9 48

M. L. Ochs

For corners in <u>Newaygo</u> (County)	Located in:	Corner Code #
1. Public Land Survey	T <u>15N</u> R <u>12W</u>	<u>D-11</u>
	T _____ R _____	_____
	T _____ R _____	_____
	T _____ R _____	_____
2. Property Controlling in Section	S _____ T _____ R _____	_____
	S _____ T _____ R _____	_____
3. Miscellaneous Property in Sec.	S _____ T _____ R _____	_____
	S _____ T _____ R _____	_____
4. Lot No. _____, Recorded Plat _____		
5. Private Claims _____		

Register of Deeds Stamp & File Number

A	B	C	D	E	F	G	H	I	J	K	L	M
2	6	5	4	3	2							
3												
4	7	8	9	10	11	12						
5												
6	18	17	16	15	14	13						
7												
8												
9	19	20	21	22	23	24						
10												
11												
12	30	29	28	27	26	25						
13												
	31	32	33	34	35	36						

I, Norman L. Ochs, in a field survey on November 6, 1995, do hereby certify that under requirements of P. A. 74, Michigan P.A. of 1970, the corner points mentioned in lines 1 and 2 above were in conformance with regulations and rules therefore as required in the current manual of survey instructions of the United States Department of the Interior, Bureau of Land Management or by a decree of a Court of Law and/or that the corner points mentioned in lines 3, 4 and 5 above were in conformance with the rules of the Michigan Board of Land Surveyors or by a Decree of a Court of Law; established, re-established, monumented, re-monumented, recovered, found as expressed below:

Note: Not more than 4 corners, all in the same town and range, may be recorded on this certificate.

N. 1/4 Corner, Section 32, Monroe Twp., Newaygo Co., MI

A. DESCRIPTION OF ORIGINAL MONUMENT AND ACCESSORIES AND/OR SUBSEQUENT RESTORATION:

- G.L.O. Milton Nye 1856
6" Beech N56 1/2°E 19Lks (12.54') #1
22" W. Pine S38°W 8Lks (5.28') #2
- Lyle S. Shepherd RLS #503
Witness Book No. 1 Pg. 84
24" Pine Stp. S34 1/4°W 92 1/2' #3
24" Pine Stp. N51 1/2°E 70' #4
- Norman L. Ochs RLS #22439
LCRC #471 June 7, 1976
Found 1" Sq. Iron
24" W. Oak S66°W 77.02' #5
S.E. Cor. hse. N35°W 134.80' #7
P. Pole East 43.40' #8
Measured 2650.15 ft from the S.W. Cor. to the S. 1/4 Cor. of Sec. 29 and measured 2630.48 ft from the S. 1/4 Cor. to the S.E. Cor. of Sec. 29 and measured 2646.75 ft from the S. 1/4 Cor. to the C. 1/4 Cor. of Sec. 29
- Lyle S. Shepherd, RLS #503 Book 71 Pg. 150 October 22, 1948
Found 3" Pine stake and 1" Sq. Iron
14" W. Oak S62°30'W 76.4' #5
C.C.C. Tel. Pole N64°W 40.0' #6
S.E. Cor. hse. N40°W 134.8' #7
Measured 2640 ft from the N. 1/4 Cor. to the C. 1/4 Cor. of Sec. 32
- Ralph A. Smith RLS #3421
Book 88 Pg. 16 1957
1" Sq. Iron 3" Pine Stake
14" W. Oak S62 1/2°W 76.4' #5
S.E. Cor. hse. N40°W 134.8' #7
- Robert A. Griffin RLS #13584 1973
Found 1 1/4" Iron
P. Pole N82°E 43.36' #8
14" W. Oak S62°W 76.4' #5
S.W. Cor. of house N82°E 43.36' #9
Measured 2649.46 ft from the N.W. Cor. to the N. 1/4 Cor. of Sec. 32 and
Measured 2638.95 ft from the N. 1/4 Cor. to the C. 1/4 Cor. of Sec. 32

OVER

B. DESCRIPTION OF CORNER EVIDENCE FOUND AND/OR METHOD APPLIED IN RESTORING OR REESTABLISHING CORNER:

Found 1" Sq. iron and pine wood stake in centerline of N & S road and the centerline of the road going West is 18 ft South and the centerline of the trail road going East is 24 ft South and the conditions of the recorded witnesses are: #1 thru #6 gone, #7 and #8 good condition, #9 no house or foundation there now.

C. DESCRIPTION OF MONUMENT FOR CORNER AND ACCESSORIES ESTABLISHED TO PERPETUATE LOCATING THE POSITION OF THE CORNER:

Removed 1" Sq. iron and pine wood stake and set a 4" dia. Harrison cast iron monument 20" long marked "County Surveyor" as a substantial marker for the section corner and is accepted as a careful and faithful reestablishment of the original corner.


- S.E. Cor. house N40°W 134.70' #7
- P. Pole East 43.37' #8
- 12" W. Oak S65°W 95.76'
- 12" W. Oak S45°W 59.5' Spike in Southeast side of tree.
- Concrete monument East 33.03'

Signed by Norman L. Ochs Date December 12, 1995

Surveyor's Michigan License No. 22439

Form approved by Michigan State Board of Land Surveyors

Revised May 14, 1975
Revised Jan., 1983

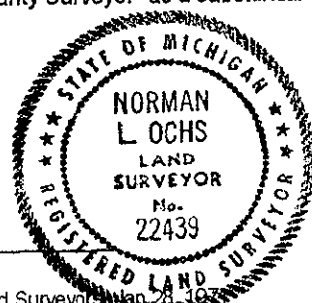

Approved by Peer Review Group On December 13, 1995

A. Description ... (Continued)

Newaygo Engineering and Survey Co.

Sec. break, Sec. 32 July 6, 1977

Found 1" Sq. Iron

Measured 2650.15 ft from the N.W. Cor. to the N. $\frac{1}{4}$ Cor. of Sec. 32 and measured 2638.84 ft from the N. $\frac{1}{4}$ Cor. to the C. $\frac{1}{4}$ Cor. of Sec. 32 and measured 2630.48 ft from the N. $\frac{1}{4}$ Cor. to the N.E. Cor. of Sec. 32