

SURVEY & REMONUMENTATION

APR 24 1995

1994 NEWAYGO COUNTY REMONUMENTATION PROJECT COMMISSION LAND CORNER RECORDATION CERTIFICATE Filing Requirement of Act 74, Mich. P.A. 1970

VOL. 001 PAGE 135

For corners in


Newaygo (County)	Located In:		Corner Code #
	15N	13W	
1. Public Land Survey	T	R	C-3
	T	R	
	T	R	
	T	R	
2. Property Controlling in Section	S	R	
	S	R	
3. Miscellaneous Property in Sec.	S	R	
	S	R	

NEWAYGO COUNTY
REGISTER OF DEEDS
MARLENE TOOGOOD

95 MAR 14 PM 3 5

Marlene Toogood
Register of Deeds Stamp & File Number

4. Lot No. _____ Recorded Plat _____
5. Private Claims _____

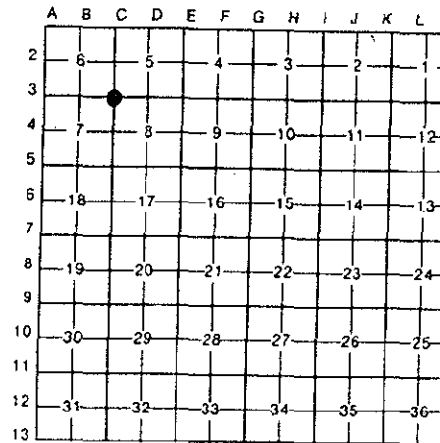

I, Norman L. Ochs, in a field survey on December 1, 1994, do hereby certify that under requirements of P.A. 74, Michigan P.A. of 1970, the corner points mentioned in lines 1 and 2 above were in conformance with regulations and rules therefore as required in the current manual of survey instructions of the United States Department of the Interior, Bureau of Land Management or by a decree of a Court of Law and/or that the corner points mentioned in lines 3, 4 and 5 above were in conformance with the rules of the Michigan Board of Land Surveyors or by a Decree of a Court of Law, established, re-established, monumented, re-monumented, recovered, found as expressed below:

NOTE: Not more than 4 corners, all in the same town and range, may be recorded on this certificate.
N.W. Corner, Section 8, Merrill Twp., Newaygo Co., MI

A. Description of original monument and accessories and/or subsequent restoration:

C-3 - Northwest corner Section 8, T15N, R13W, Merrill Township, Newaygo County, Michigan.

G.L.O. - Milton Nye - 1856
12" Elm N18°E 110 Links (72.6') #1
24" W. Pine S4°E 80 Links (52.8') #2
Stream 20 Links (13.2') Wide Stream
is East 6.12 Chains (403.92')

Delos G. Anderson - County Surveyor - May 9 to 14, 1900
Book A Pages 297 and 298
12" Elm N77-1/2°W 1.00 Links (.66') #3
Measured 40 Chains (2640') from the Northeast corner to the North 1/4 corner Section 7. Measured 40 Chains (2640') from Southeast corner to East 1/4 corner Section 6. Measured 39.97 chains (2638.02') from Northwest corner to North 1/4 corner Section 8.

(SEE OVER FOR CONTINUATION OF "A")

B. Description of corner evidence found and/or method applied in restoring or reestablishing corner:

C-3 - Northwest corner Section 8, T15N, R13W, Merrill Township, Newaygo County, Michigan.


I found 5" x 36" U.S.F.S. monument 3 feet North of the centerline of blacktop road. Also found 1" x 30" axle shaft 106.61 feet West (30" below road surface) in centerline of road to South. I accepted the U.S.F.S. monument as the correct position, as it fits well with Delos Anderson's distances from 1900 and it fits well with the G.L.O. stream crossing (408' more or less) to the East. Condition of the accessories are as follows: #1 gone, #2 Gone, #3 Gone, #4 Gone, #5 Gone, #6 Found stump, #7 Found in good condition, #8 Gone, #9 Found in good condition, #10 Found damaged.

C. Description of monument for corner and accessories established to perpetuate locating the position of the corner:

C-3 - Northwest corner Section 8, T15N, R13W, Merrill Township, Newaygo County, Michigan.

I accepted the U.S.F.S. concrete monument as a substantial marker for the corner, and is accepted as a careful and faithful re-establishment of the position of the original corner.

"X" in S. side of West C.M.P. S81°E 408.88 (#7)
Northern most bolt in top of Concrete Block S50°W 45.89' (#9)
10"-12" Twin Elm S26°W 42.82' (60d spike in W. side)
10" Elm S35°E 53.47' (60d spike in E. side)

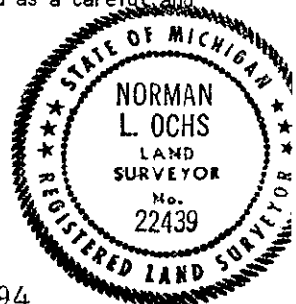

Signed by *Norman L. Ochs*
Surveyor's Michigan License No. 22439

Date December 13, 1994

Approved By Peer Review Group on December 8, 1994
Norman L. Ochs County Representative *on file*

CONTINUATION OF "A" - DESCRIPTION OF ORIGINAL MONUMENT AND ACCESSORIES AND/OR SUBSEQUENT RESTORATION:

George H. Johnson 1925

Iron L.C.R.C. #122

12" B. Oak N88°W 264.5' #4

N.C.R.C. Sheet

Iron

8" Poplar S46°W 68.7' #5

14" Poplar S01°W 40.75' #6

Robert A. Griffin, R.L.S. #13584, L.C.R.C. #122 (also recovered witnesses from N.C.R.C.) - August 17, 1967

Found 3/4" Iron 110 feet East of centerline of a gravel road South and 3 feet North of centerline of East and West pavement.

Replaced with 5" Square reinforced concrete post with brass disk on top.

"X" cut in top center of South end of the West C.M.P. S85°E 408.80' #7

3" B. Ash S33°E 67.02' #8

Center of North Bolt in top of concrete block S45°W 45.90' #9

4"x 7' Pine Post North 33' (pushed over from ice action) #10.

Center of brass disk is the Concrete monument marking 1/4 Section corner common to Sections 6 and 7 is West 2644.95 feet.

Clinton E. Cole, L.S. 17615

Used this corner in 1980. He measured 2689.96 feet to the 1/4 corner common to Sections 5 and 8.

Robert L. Wetherell, LS 24624 - 1989

U.S.F.S. Monument

Found axle shaft 106 feet West of corner.