

SURVEY & REMONUMENTATION

MAR 19 1998

1997 Newaygo County Remonumentation Project

LAND CORNER RECORDATION CERTIFICATE
FILING REQUIREMENT of Act 74, Mich. P.A. 1970

NEWAYGO COUNTY
REGISTER OF DEEDS
LINDA M. BROWN

'98 MAR 6 PM 12 37

Linda M. Brown

SECTION

For corners in <u>Newaygo</u> (County)	Located in:	Corner Code #
1. Public Land Survey	T <u>15N</u> R <u>13W</u>	<u>E-11</u>
	T ___ R ___	_____
	T ___ R ___	_____
	T ___ R ___	_____
2. Property Controlling in Section	S ___ T ___ R ___	_____
	S ___ T ___ R ___	_____
3. Miscellaneous Property in Sec.	S ___ T ___ R ___	_____
	S ___ T ___ R ___	_____
4. Lot No. _____, Recorded Plat _____		
5. Private Claims _____		

VOL. 2

127

Register of Deeds Stamp & File Number

	A	B	C	D	E	F	G	H	I	J	K	L	M
1													
2	6	5	4	3	2	1							
3													
4	7	8	9	10	11	12							
5													
6	18	17	16	15	14	13							
7													
8	19	20	21	22	23	24							
9													
10	30	29	28	27	26	25							
11													
12	31	32	33	34	35	36							
13													

I, Norman L. Ochs, in a field survey on August 7, 1997, do hereby certify that under requirements of P. A. 74, Michigan P.A. of 1970, the corner points mentioned in lines 1 and 2 above were in conformance with regulations and rules therefore as required in the current manual of survey instructions of the United States Department of the Interior, Bureau of Land Management or by a decree of a Court of Law and/or that the corner points mentioned in lines 3, 4 and 5 above were in conformance with the rules of the Michigan Board of Land Surveyors or by a Decree of a Court of Law; established, re-established, monumented, re-monumented, recovered, found as expressed below:

Note: Not more than 4 corners, all in the same town and range, may be recorded on this certificate.

Northwest Corner, Section 33, Merrill Township, Newaygo County, Michigan

A. DESCRIPTION OF ORIGINAL MONUMENT AND ACCESSORIES AND/OR SUBSEQUENT RESTORATION:

G.L.O. Milton Nye Resurvey 1856
14" White Pine N59° 7 Links (4.62') #1
8" White Pine S63°W 5 Links (3.3') #2

Robert A. Griffin R.L.S. #13584
LCRC #577 September 11, 1980
Found G.L.O. witness stump remains. Found 1 1/2" Angle Iron by chaining South from the East One Quarter Corner of Section 29 a distance of 2630.76 feet from the 1908 William M. Jacques (County Surveyor) survey at the East One Quarter Corner Section 29, an angle iron was found, so this reinforces our thinking that Jacques used angle irons as monuments. Replaced 1 1/2" angle iron with 5" square X 36" Concrete monument with brass cap in exact location.
7" Black Oak N70°W 5.68' #3
7" Black Oak N05°E 20.18' #4
8" Black Oak S38°E 41.24' #5
4" Pine Post South 1.71' #6


B. DESCRIPTION OF CORNER EVIDENCE FOUND AND/OR METHOD APPLIED IN RESTORING OR REESTABLISHING CORNER:

Found Robert A. Griffin's 5" square concrete monument on woods line going West. The centerline of the North and South trail road is 12 feet West. The condition of the recorded witnesses are: #1 gone, #2 stump, #3 thru #6 good condition.

C. DESCRIPTION OF MONUMENT FOR CORNER AND ACCESSORIES ESTABLISHED TO PERPETUATE LOCATING THE POSITION OF THE CORNER:

Accepted Robert A. Griffin's concrete monument as a substantial marker for the section corner and is accepted as a perpetuation of the position of the original corner.

24" White Pine Stump S63°W 3.63' to center. #2
12" Black Oak S70°E 5.70' Found spike and tag #13584 in North side of tree. #3
14" Black Oak N08°E 20.15' Found big spike in East side of tree. #4
14" Black Oak S35°E 41.25' Found spike bent with nail above it in Northeast side of tree. #5
4" Pine Post South 1.71' Found nail in West side of post. #6
14" White Oak West 41.43' Set spike and tag in South side of tree.

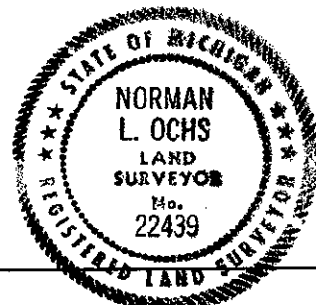

Signed by Norman L. Ochs Date October 7, 1997

Surveyor's Michigan License No. 22439 Form approved by Michigan State Board of Land Surveyors, Jan 28, 1971

Approved by Peer Review Group on November 11, 1997
Norman L. Ochs, County Representative.

N. L. O.

Revised May 14, 1975
Revised Jan., 1983