

REMONUMENTATION

MAY 28 1997

COMMISSION

1996 Newaygo County Remonumentation Project

LAND CORNER RECORDATION CERTIFICATE  
FILING REQUIREMENT of Act 74, Mich. P.A. 1970

NEWAYGO COUNTY  
REGISTER OF DEEDS  
LINDA M. BROWN

'97 FEB 12 PM 4 45

*Linda M. Brown*

For corners in Newaygo Located in: \_\_\_\_\_ Corner Code # \_\_\_\_\_  
(County)

- 1. Public Land Survey T 15N R 13W L-11  
T \_\_\_\_\_ R \_\_\_\_\_  
T \_\_\_\_\_ R \_\_\_\_\_  
T \_\_\_\_\_ R \_\_\_\_\_
- 2. Property Controlling S \_\_\_\_\_ T \_\_\_\_\_ R \_\_\_\_\_  
in Section S \_\_\_\_\_ T \_\_\_\_\_ R \_\_\_\_\_
- 3. Miscellaneous S \_\_\_\_\_ T \_\_\_\_\_ R \_\_\_\_\_  
Property in Sec. S \_\_\_\_\_ T \_\_\_\_\_ R \_\_\_\_\_
- 4. Lot No. \_\_\_\_\_, Recorded Plat \_\_\_\_\_
- 5. Private Claims \_\_\_\_\_

VOL. 2 PAGE 30

Register of Deeds Stamp & File Number

	A	B	C	D	E	F	G	H	I	J	K	L	N
2													
3													
I, Norman L. Ochs, in a field survey on September 9, 1996, do hereby certify that under requirements of P. A. 74, Michigan P.A. of 1970, the corner points mentioned in lines 1 and 2 above were in conformance with regulations and rules therefore as required in the current manual of survey instructions of the United States Department of the Interior, Bureau of Land Management or by a decree of a Court of Law and/or that the corner points mentioned in lines 3, 4 and 5 above were in conformance with the rules of the Michigan Board of Land Surveyors or by a Decree of a Court of Law; established, re-established, monumented, re-monumented, recovered, found as expressed below:

Note: Not more than 4 corners, all in the same town and range, may be recorded on this certificate.

North One Quarter Corner, Section 36, Merrill Township, Newaygo County, Michigan

A. DESCRIPTION OF ORIGINAL MONUMENT AND ACCESSORIES AND/OR SUBSEQUENT RESTORATION:

G.L.O. Milton Nye 1856  
8" White Pine Corner tree  
5" White Pine N72½°E 12 Links (7.92')#1  
6" White Pine S62°W 6 Links (3.96')#2

Delos G. Anderson (County Surveyor)  
Book A Page 359 September 25, 1902  
8" White Pine Corner tree (Old Government Corner)  
5" White Pine N72½°E 12 Links (7.92')#1  
6" White Pine S62°W 6 Links (3.96')#2

J.C. Brewster (County Surveyor)  
Book A Page 123 December 9, 1892  
½ way on line iron Bar equal distance between section corners

T.H. McArdle and Lyle Shepherd R.L.S. #503  
LCRC #160 Michigan State Highway Department 1919  
1" Gas Pipe  
Fence Post Northeast 37.7' #3  
Fence Post Southwest 29.8' #4

Lyle S. Shepherd R.L.S. #503 1948  
Witness Book Number 1 Page 98 Found Flat Iron  
12" Black Oak N60°E 49' #5  
14" White Pine S55°E 65' #6

OVER ↙

B. DESCRIPTION OF CORNER EVIDENCE FOUND AND/OR METHOD APPLIED IN RESTORING OR REESTABLISHING CORNER:

Found Robert A. Griffin's concrete monument with brass disk in centerline of road going West and in centerline of M-37 going North and the centerline of road going East is 6 feet North and there is a fence going South and the condition of the recorded witnesses are: #1 thru #4 gone, #5 thru #8 good condition, #9 thru #10 gone.

C. DESCRIPTION OF MONUMENT FOR CORNER AND ACCESSORIES ESTABLISHED TO PERPETUATE LOCATING THE POSITION OF THE CORNER:


Accepted Robert A. Griffin's concrete monument with brass disk as a substantial marker for the section corner and is accepted as a careful and faithful reestablishment of the original corner.

- 24" Twin Black Oak N60°E 49.11' Set spike and tag in Northwest side of tree. #5
- 22" White Pine S55°E 64.95' Found spike in Southwest side of tree. #6
- 14" White Oak N70°E 73.46' Found big spike in Southeast side of tree. #7
- 4" X 7" Pine post North 33.00' #8
- 8" White Oak S30°E 94.47' Set spike and tag in East side of tree.
- ½" Iron and cap #17615 South 33.00'

Signed by Norman L. Ochs Date September 13, 1996  
Norman L. Ochs

Surveyor's Michigan License No. 22439 Form approved by Michigan State Board of Land Surveyors, Jan 28, 1971

Approved by Peer Review Group On September 17, 1996 Revised May 14, 1975  
Norman L. Ochs, County Representative. Revised Jan., 1983

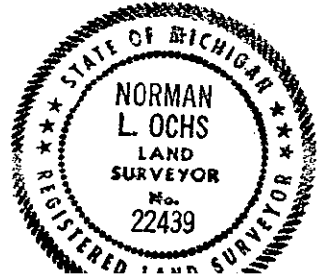

*N. L. O.*

A. Description (cont.)

Robert A. Griffin R.L.S. #13584 LCRC #160

Found 1 1/4" X 36" Well Point with flat iron bar

Replaced with 5" Square concrete post with brass disk

8" White Oak N70°E 73.24' #7

22" White Pine S60°E 65.15' #6

4" X 7" Pine Post North 33' #8

7" White Oak S30°E 76.57' #9

8" White Oak S74°W 106.14' #10

Clinton E. Cole R.L.S. #17615

Recorded in Series S Number 725 January 6, 1986

8" White Oak N70°E 73.24' #7

22" White Pine S60°E 65.15' #6

7" White Oak S30°E 76.57' #9