

REMONUMENTATION PROJECT

1993 NEWAYGO COUNTY REMONUMENTATION PROJECT

1993

NEWAYGO COUNTY REGISTER OF DEEDS MARLENE TOOGOOD

LAND CORNER RECORDATION CERTIFICATE

Filing Requirement of Act 74, Mich. P.A. 1970

94 JAN 21 PM 3 27

COMMISSION

For corners in

<u>NEWAYGO</u> (County)	Located In:	Corner Code #
1. Public Land Survey	T <u>15N</u> R <u>14W</u>	<u>A-2</u>
	T _____ R _____	_____
	T _____ R _____	_____
	T _____ R _____	_____
2. Property Controlling in Section	S _____ T _____ R _____	_____
	S _____ T _____ R _____	_____
3. Miscellaneous Property in Sec.	S _____ T _____ R _____	_____
	S _____ T _____ R _____	_____

Marlene Toogood
VOL 001 PAGE 48

Register of Deeds Stamp & File Number

- 4. Lot No. _____, Recorded Plat _____
- 5. Private Claims _____

A	B	C	D	E	F	G	H	I	J	K	L	M
6	5	4	3	2	1							
7	8	9	10	11	12							
18	17	16	15	14	13							
19	20	21	22	23	24							
30	29	28	27	26	25							
31	32	33	34	35	36							

I, Norman L. Ochs, in a field survey on December 4, 19 93, do hereby certify that under requirements of P.A. 74, Michigan P.A. of 1970, the corner points mentioned in lines 1 and 2 above were in conformance with regulations and rules therefore as required in the current manual of survey instructions of the United States Department of the Interior, Bureau of Land Management or by a decree of a Court of Law and/or that the corner points mentioned in lines 3, 4 and 5 above were in conformance with the rules of the Michigan Board of Land Surveyors or by a Decree of a Court of Law; established, re-established, monumented, re-monumented, recovered, found as expressed below:

NOTE: Not more than 4 corners, all in the same town and range, may be recorded on this certificate.


W-1/4 corner, Sec. 6, Beaver Twp.

A. Description of original monument and accessories and/or subsequent restoration:
 G.L.O. George Blass for C.P. Co. (See Sec. 1, T15N R15W, Leavitt Twp., Oceana Co., Mich. C.P. Co. Section break)
 8" Beech S25°W 10 lks. #1 1968 Fd. 1/2" iron rod/raised
 10" Hemlock N16°W 12 lks #2 W/RR. Spk.
 Fe Post N88°W 28.28' #3
 18" Ash S88°E 37.49' #4
 12" Maple N20°W 65.48' #5

B. Description of corner evidence found and/or method applied in restoring or reestablishing corner:
 Located "T" iron. Found no previous information as to who set it.
 Fits good with witnesses. Set 4" Harrison cast iron monument.

Condition of recorded witnesses is: #1 gone, #2 gone, #3 gone, #4 good condition, #5 good condition.

C. Description of monument for corner and accessories established to perpetuate locating the position of the corner:
 Set 4" Harrison cast iron monument as a substantial marker for the 1/4 corner, and is accepted as a careful and faithful re-establishment of the position of the original corner.
 25" Ash S88°E 36.97' Nail in South side of tree #4.
 25" Maple N10°W 65.39' Nail in East side of tree #5.
 30" Beech 47.95' S26°E 47.95' Nail in West side of tree.
 12" Ash S35°W 65.46' Nail in East side of tree.

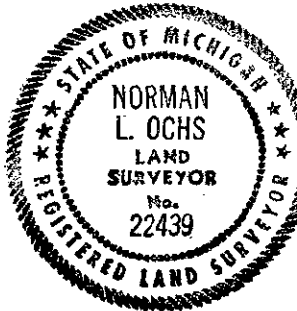

Signed by Norman L. Ochs Date December 20, 1993
 Surveyor's Michigan License No. 22439

Approved by Peer Review Group December 27, 1993
 Norman L. Ochs, County Representative