

**SURVEY &
REMONUMENTATION**

APR 24 1995

1994 NEWAYGO COUNTY REMONUMENTATION PROJECT
LAND CORNER RECORDATION CERTIFICATE

COMMISSION

Filing Requirement of Act 74, Mich. P.A. 1970

Vol. 001 P139
VOL 001 NEWAYGO COUNTY
REGISTER OF DEEDS
MARLENE TOOGOOD

For corners in

Newaygo

(County)

Located In:

Corner Code #

- | | | |
|------------------------------------|---------------------------|-------|
| 1. Public Land Survey | T <u>15N</u> R <u>14W</u> | D-5 |
| | T _____ R _____ | _____ |
| | T _____ R _____ | _____ |
| | T _____ R _____ | _____ |
| 2. Property Controlling in Section | S _____ T _____ R _____ | _____ |
| | S _____ T _____ R _____ | _____ |
| 3. Miscellaneous Property in Sec. | S _____ T _____ R _____ | _____ |
| | S _____ T _____ R _____ | _____ |

'95 MAR 14 PM 3 5

Marlene Toogood

Register of Deeds Stamp & File Number

4. Lot No. _____, Recorded Plat _____
5. Private Claims _____

A	B	C	D	E	F	G	H	I	J	K	L	M
2	6	5	4	3	2	1						
3												
4	7	8	9	10	11	12						
5												
6	18	17	16	15	14	13						
7												
8	19	20	21	22	23	24						
9												
10	30	29	28	27	26	25						
11												
12	31	32	33	34	35	36						
13												

I, Norman L. Ochs, in a field survey on December 1, 19 94

do hereby certify that under requirements of P.A. 74, Michigan P.A. of 1970, the corner points mentioned in lines 1 and 2 above were in conformance with regulations and rules therefore as required in the current manual of survey instructions of the United States Department of the Interior, Bureau of Land Management or by a decree of a Court of Law and/or that the corner points mentioned in lines 3, 4 and 5 above were in conformance with the rules of the Michigan Board of Land Surveyors or by a Decree of a Court of Law; established, re-established, monumented, re-monumented, recovered, found as expressed below:

NOTE: Not more than 4 corners, all in the same town and range, may be recorded on this certificate.

S. 1/4 Corner, Section 8, Beayer Twp., Newaygo County, MI

A. Description of original monument and accessories and/or subsequent restoration:

G.L.O. Thomas Whelpley 1856
12" Hemlock S51°E 21 lks. (13.86') #1
10" Hemlock N65 1/2°W 10 lks. (6.60') #2

OVER----->

George Blass R.L.S. #5489 March 1968 Found 1/2" Pipe
Fence Post S01°E 27.63' #3 Did section break for Consumers Power Co., Drawing No. S-F 17051. Measured 2620.23
P. Pole N56°W 69.94' #4 feet from the S. 1/4 Cor. to the S.W. Cor. of Sec. 8 and measured 2629.16 feet from the
10" Cedar N66°E 54.25' #5 S. 1/4 Cor. to the C. 1/4 Cor. of Sec. 8 and measured 2593.12 feet from the S. 1/4 Cor.
"X" on rock S71°E 70.12' #6 to the S.E. Cor. of Sec. 8.


B. Description of corner evidence found and/or method applied in restoring or reestablishing corner:

I found a 1/2" pipe 2.5 feet below road surface 3 feet South of centerline of East and West gravel road in line with fence to South (new fence built over old fence). Condition of recorded witnesses are: #1 thru #3 Gone, #4 and #5 Good Condition.

C. Description of monument for corner and accessories established to perpetuate locating the position of the corner:

Removed 1/2" pipe and set a 4" dia. Harrison Cast Iron Monument 20" long marked "County Surveyor" as a substantial marker for the section corner and is accepted as a careful and faithful reestablishment of the position of the original corner.

P. Pole N51°W 69.94' (Found Blass Tag - set 60d spike above tag) #4
18" Cedar N71°E 54.33' (Found Blass Tag - set 60d spike above tag) #5
"X" on a 3 foot Stone S67°E 70.09' #6
9" Cedar Fence Post S05°W 28.87' (60d spike in West side of tree)

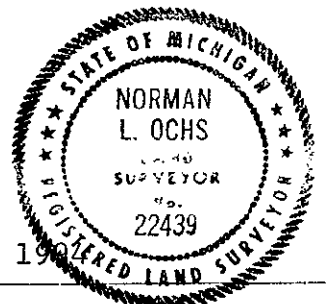

Signed by *Norman L. Ochs*
Surveyor's Michigan License No. #22439

Date December 13, 1994

Approved by Peer Review Group on December 15, 1994
Norman L. Ochs, County Representative. *N.L.O.*

A. Description..... (Cont.)

Paul Paquette R.L.S. #16938 July 23, 1973

Recorded in Series F, No. 3964

Measured 2620.22 feet from the S. 1/4 Cor. to the S.W. Cor. of Sec. 8 and measured 2629.16 feet from the S. 1/4 Cor. to the C. 1/4 Cor. of Sec. 8 and measured 2693.12 feet from the S. 1/4 Cor. to the S.E. Cor. of Sec. 8.