

SURVEY & REMONUMENTATION

MAR 19 1998

1997 Newaygo County Remonumentation Project

NEWAYGO COUNTY
REGISTER OF DEEDS
LINDA M. BROWN

SECTION

LAND CORNER RECORDATION CERTIFICATE
FILING REQUIREMENT of Act 74, Mich. P.A. 1970

'98 MAR 6 PM 12 37

Linda M. Brown

For corners in Newaygo (County)	Located in:	Corner Code #
1. Public Land Survey	T 15N R 14W	G-3
	T _____ R _____	_____
	T _____ R _____	_____
	T _____ R _____	_____
2. Property Controlling in Section	S _____ T _____ R _____	_____
	S _____ T _____ R _____	_____
3. Miscellaneous Property in Sec.	S _____ T _____ R _____	_____
	S _____ T _____ R _____	_____
4. Lot No. _____, Recorded Plat _____		
5. Private Claims _____		

VOL. 2

117

Register of Deeds Stamp & File Number

	A	B	C	D	E	F	G	H	I	J	K	L	M
1													
2	6		5		4		3		2		1		
3							●						
4	7		8		9		10		11		12		
5													
6	18		17		16		15		14		13		
7													
8	19		20		21		22		23		24		
9													
10	30		29		28		27		26		25		
11													
12	31		32		33		34		35		36		
13													

I, Norman L. Ochs, in a field survey on November 10, 1997, do hereby certify that under requirements of P. A. 74, Michigan P.A. of 1970, the corner points mentioned in lines 1 and 2 above were in conformance with regulations and rules therefore as required in the current manual of survey instructions of the United States Department of the Interior, Bureau of Land Management or by a decree of a Court of Law and/or that the corner points mentioned in lines 3, 4 and 5 above were in conformance with the rules of the Michigan Board of Land Surveyors or by a Decree of a Court of Law; established, re-established, monumented, re-monumented, recovered, found as expressed below:

Note: Not more than 4 corners, all in the same town and range, may be recorded on this certificate.

Southeast Corner, Section 4, Beaver Township, Newaygo County, Michigan

A. DESCRIPTION OF ORIGINAL MONUMENT AND ACCESSORIES AND/OR SUBSEQUENT RESTORATION:

G.L.O. Milton Nye Resurvey 1856 14" Black Ash S28°W 3 Links (1.98') #1 14" Black Ash N52°E 27 Links (17.82') #2 14" Hemlock N80½°W 27 Links (17.82') #3	Delos G. Anderson (County Surveyor) Book A. Page 216 September 14, 1897 Old Government Corner
William M. Jacques (County Surveyor) March 10, 1903 Book 1 of Register of Deeds Found the old stake and set an iron in its place.	Newaygo County Road Commission ½" Iron (Approx.) 8" Pignut N53°W 51.3' #4 Power Pole S68°E 127.76' #5 ¾" Iron N02°E 33.0' #6

George Blass R.L.S. #5489
Consumers Power Company Section Break
March 10, 1968 Set P.K. Nail from old witnesses
Power Pole S68°E 127.76' #5
¾" Iron N02°E 33.00' #6
8" Ash N50°W 51.18' #4
Buried Cable Marker S62°E 56.32' #7

B. DESCRIPTION OF CORNER EVIDENCE FOUND AND/OR METHOD APPLIED IN RESTORING OR REESTABLISHING CORNER:

Found ½" by 20" Rerod 18" below grade in line with fence going South and in line with remnants of fence going North. The centerline of the East and West bituminous road is 1 foot North. The centerline of two-track going South is 10 feet East. The condition of the recorded witnesses are: #1 thru #3 gone, #4 thru #6 good condition, #7 gone.

C. DESCRIPTION OF MONUMENT FOR CORNER AND ACCESSORIES ESTABLISHED TO PERPETUATE LOCATING THE POSITION OF THE CORNER:


Removed ½" by 20" rerod and set a 4" diameter Harrison cast iron monument 20" long marked "County Survey" as a substantial marker for the section corner and is accepted as a careful and faithful reestablishment of the original corner.

14" Ash (blazed) N50°W 51.30' Set spike and brass washer #22439 in South side of tree #4
Power Pole S70°W 127.90' Set spike and brass washer #22439 in North side of pole #5
¾" Iron Pipe N04°E 32.96' #6
10" Elm (blazed) N52°E 43.00' Set spike and brass washer #22439 in Northwest side of tree
14" Ash (blazed) S17°E 82.15' Set spike and brass washer #22439 in East side of tree

Signed by Norman L. Ochs Date November 11, 1997

Surveyor's Michigan License No. 22439

Form approved by Michigan State Board of Land Surveyors and Surveyors

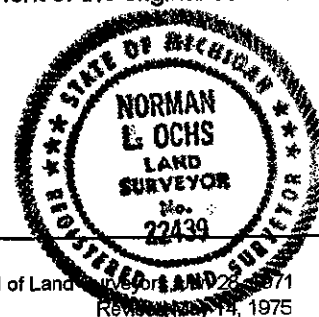

Approved by Peer Review Group on November 11, 1997
Norman L. Ochs, County Representative.

Revised Jan., 1983

N.L.O.