

MAY 28 1997

LAND CORNER RECORDATION CERTIFICATE FILING REQUIREMENT of Act 74, Mich. P.A. 1970

'97 FEB 12 PM 4 45

COMMISSION

Form with fields: For corners in Newaygo (County), Located in: T 15N R 14W, Corner Code # G-11, 1. Public Land Survey, 2. Property Controlling in Section, 3. Miscellaneous Property in Sec., 4. Lot No., Recorded Plat, 5. Private Claims

Linda M. Brown

VOL. 2 PAGE 32

Register of Deeds Stamp & File Number

I, Norman L. Ochs, in a field survey on September 6, 1996, do hereby certify that under requirements of P. A. 74, Michigan P.A. of 1970, the corner points mentioned in lines 1 and 2 above were in conformance with regulations and rules therefore as required in the current manual of survey instructions of the United States Department of the Interior, Bureau of Land Management or by a decree of a Court of Law and/or that the corner points mentioned in lines 3, 4 and 5 above were in conformance with the rules of the Michigan Board of Land Surveyors or by a Decree of a Court of Law; established, re-established, monumented, re-monumented, recovered, found as expressed below:

Note: Not more than 4 corners, all in the same town and range, may be recorded on this certificate.

Northwest Corner, Section 34, Beaver Township, Newaygo County, Michigan

Grid table with columns A-M and rows 2-13. A dot is marked at the intersection of column G and row 11.

A. DESCRIPTION OF ORIGINAL MONUMENT AND ACCESSORIES AND/OR SUBSEQUENT RESTORATION:

- G.L.O. Thomas Whelpley Resurvey 1856
12" Beech S58°W 15 Links (9.90')#1
16" Beech S24½°E 28 Links (18.48')#2
18" Beech N45°E 28 Links (18.48')#3
Delos G. Anderson (County Surveyor)
Book A Page's 247 & 248 March 30 & 31, 1899
Book A Page's 339 & 340 March 24, 25, 26, 1902
Found rotten remains of old stake
36" Pine Stump N04°E 50 Links (33')#4
20" Pine Stump S36°E 41 Links (27.06')#5
William M. Jacques (County Surveyor)
June 17, 1907 Book 23 Page 9
36" Pine Stump S70½°E 50 Links (33')#6
42" Pine Stump S83°W 50 Links (33')#7
County Surveyor Witness Book Page 134
36" Pine Stump S44½°E 44' #9
20" Pine Stump S36°E 41 Links (27.06')#5
George Blass R.L.S. #5489
Consumers Power Company Section Break 1968
Found Railroad Spike
Clump Cherry S38°E 49.26' #12
Buried Cable Marker N48°W 34.82' #13
9" Cherry S56°W 75.97' #14
Lyle S. Shepherd R.L.S. #503
County Surveyor Witness Book Page 136 January 8, 1920
5" Pine S54°10'E 49.2' #10
14" Oak N73°E 98.2' #11
J. Randolph Hepworth R.L.S. #26457
April 29, 1989 Job Number 89064
Set ½" Iron by Consumers Power Company Witnesses
Buried Cable Post N48°W 34.82' #13
Clump Cherry S38°E 49.26' #12
12" Cherry Stump S56°W 75.97' #14
Road Name Sign East 18.7' #15
4" Red Pine N36°W 65.18' #16

B. DESCRIPTION OF CORNER EVIDENCE FOUND AND/OR METHOD APPLIED IN RESTORING OR REESTABLISHING CORNER:


Found ½" rod and cap #26457 in centerline of North and South road and in centerline of trail road going West and the condition of the recorded witnesses are: #1 thru #11 gone, #12 good condition, #13 and #14 gone, #15 and #16 good condition.

C. DESCRIPTION OF MONUMENT FOR CORNER AND ACCESSORIES ESTABLISHED TO PERPETUATE LOCATING THE POSITION OF THE CORNER:

Removed ½" rod and cap #26457 and set a 4" diameter Harrison cast iron monument 20" long marked "County Surveyor" as a substantial marker for the section corner and is accepted as a careful and faithful reestablishment of the original corner.

- 5"-10" Clump Cherry S38°E 49.54' Set spike and tag in East side of tree. #12
Road Name Sign East 18.7' #15
12" Red Pine N32°W 65.19' Found spike in Southwest side of tree. #16
14" Ash N45°E 34.32' Set spike and tag in Northwest side of tree.
12" Red Oak S85°W 134.65' Set spike and tag in Southwest side of tree.

Signed by Norman L. Ochs Date September 13, 1996
Surveyor's Michigan License No. 22439

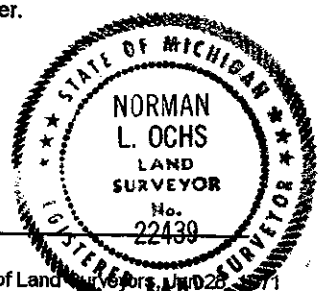

Form approved by Michigan State Board of Land Surveyors, No. 22439, Revised Jan., 1975

Approved by Peer Review Group On September 17, 1996
Norman L. Ochs, County Representative.