

REMONUMENTATION

APR 04 1996

1995 Newaygo County Remonumentation Project

COMMISSION

LAND CORNER RECORDATION CERTIFICATE
FILING REQUIREMENT of Act 74, Mich. P.A. 1970

VOL. 1 PAGE 207
NEWAYGO COUNTY
REGISTERED
MAR 21 1996

For corners in <u>Newaygo</u> (County)	Located in:	Corner Code #
1. Public Land Survey	T <u>16N</u> R <u>11W</u>	<u>E-9</u>
	T _____ R _____	_____
	T _____ R _____	_____
	T _____ R _____	_____
2. Property Controlling in Section	S _____ T _____ R _____	_____
	S _____ T _____ R _____	_____
3. Miscellaneous Property in Sec.	S _____ T _____ R _____	_____
	S _____ T _____ R _____	_____
4. Lot No. _____, Recorded Plat _____		
5. Private Claims _____		

03 FEB 21 AM 9 44
Madara Toogood

Register of Deeds Stamp & File Number

	A	B	C	D	E	F	G	H	I	J	K	L	M
2	6	5	4	3	2	1							
3													
4	7	8	9	10	11	12							
5													
6	15	17	16	15	14	13							
7													
8	19	20	21	22	23	24							
9													
10	30	29	28	27	26	25							
11													
12	31	32	33	34	35	36							

I, Norman L. Ochs, in a field survey on December 6, 1995, do hereby certify that under requirements of P. A. 74, Michigan P.A. of 1970, the corner points mentioned in lines 1 and 2 above were in conformance with regulations and rules therefore as required in the current manual of survey instructions of the United States Department of the Interior, Bureau of Land Management or by a decree of a Court of Law and/or that the corner points mentioned in lines 3, 4 and 5 above were in conformance with the rules of the Michigan Board of Land Surveyors or by a Decree of a Court of Law, established, re-established, monumented, re-monumented, recovered, found as expressed below:

Note: Not more than 4 corners, all in the same town and range, may be recorded on this certificate.

N.E. Corner, Section 29, Barton Twp., Newaygo Co., MI

A. DESCRIPTION OF ORIGINAL MONUMENT AND ACCESSORIES AND/OR SUBSEQUENT RESTORATION:

G.L.O. Milton Nye 1856 11" Hemlock N28½°E 6 Lks (3.96")#1 16" Beech S87°W 13 Lks (8.58")#2	Delos G. Anderson (Co. Surveyor) Book A. Pg.'s 177 and 178, Book 23 Pg.'s 29-31 Sept. 1895 Stone corner set by Walters. Found bottle under stone 20 yrs. old. Measured 38.11 ch (2515.26 ft) from the N. ¼ Cor. to the N.E. Cor. of Sec. 29 and measured 37.83 ch (2496.78 ft) from the N.E. Cor. to the E. ¼ Cor. of Sec. 29
William M. Jacques (Co. Surveyor) Book B Pg.'s 46 and 47, Book 21 Pg.'s 120-122 June 24, 1909 Iron Corner Measured 42.76 ch (2822.16 ft) from the S.W. Cor. to the W. ¼ Cor. of Sec. 21 and measured 40.22 ch (2654.52 ft) from the S.W. Cor to the S. ¼ Cor. of Sec. 21	Lyle S. Shepherd RLS #503 Witness Book No. 1 Pg. 126, Book 83 Pg. 21, Nov. 18, 1949 18" Maple S38°15'E 41.1' #3 18" Maple S15°E 93' #4 Fence Post S47½°E 44.8' #5 Measured 2456.50 ft from the W. ¼ Cor. to the N.W. Cor. of Sec. 28 and Measured 2654 ft from the N.W. Cor. to the N. ¼ Cor. of Sec. 28
NCRC Sheet Stone - Gas pipe Corner Post S48°W 44.8' #5 18" Maple S15°E 93.0' #4 18" Maple S38°E 41.1' #3	

OVER ↘

B. DESCRIPTION OF CORNER EVIDENCE FOUND AND/OR METHOD APPLIED IN RESTORING OR REESTABLISHING CORNER:

Found Robret A. Griffin's conc. mon. w/brass tablet #13584 and in the centerline of the E & W road and in the centerline of the N & S road and measured 2587.81 ft from the N. ¼ Cor. to the N.E. Cor. of Sec. 29 and measured 2494.39 ft from the N.E. cor. to the E. ¼ cor. of Sec. 29 and the condition of the recorded witnesses are: #1 and #2 gone, #3 and #4 good condition, #5 and #6 gone, #7 thru #9 good condition.

C. DESCRIPTION OF MONUMENT FOR CORNER AND ACCESSORIES ESTABLISHED TO PERPETUATE LOCATING THE POSITION OF THE CORNER:

Accepted R.A.G.'s conc. mon. w/brass tablet #13584 and raised with a ½" rod as a substantial marker for the section corner and is accepted as a careful and faithful reestablishment of the original corner.

- 30" Maple S38°E 43.96' Spike in Southwest side of tree. #3
- 36" Maple S15°E 94.00' Spike in Southwest side of tree. #4
- P. Pole N10°W 74.66' Spike in East side of pole. #7
- 16" Cherry N45°E 41.45' Spike in Easterly side of tree. #8
- Boulder "X" in top center S44°E 47.43' #9


Signed by Norman L. Ochs Date December 12, 1995

Surveyor's Michigan License No. 22439

Form approved by Michigan State Board of Land Surveyors, Jan 28, 1971
Revised May 14, 1975
Revised Jan., 1983

Approved by Peer Review Group On December 13, 1995
Norman L. Ochs, County Representative.

N.L.O.

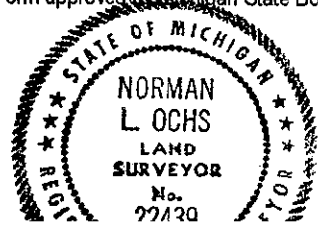

A. Description ... (Continued)

Black Index Book Sec. 29, T16N R11W (in County Surveyor's Office)

Fnd. lg. stone, glass, iron
Set 1¼" by stone, bent over stone
20" Maple S42°E 42.85' #3
20" Maple S16°E 92.66' #4
28" Elm N17°W 83.45' #6
Fence corner S47°W 40.76' #5

Robert A. Griffin RLS #13584

LCRC #535 1976

Mon. fd. pipe at intersection of roads approx 10" sq. X 16" long

30" Maple S12°E 94.26' #4

35" Maple S40°E 43.95' #3

P. Pole N16°W 74.69' #7

Robert A. Griffin RLS #13584 Jan. 1, 1981

LCRC #535 and see survey recorded in Series M. No 6305-6307

Found 1¼" X 26" iron pipe and stone in the intersection from Griffin's witnesses. Set 5" sq. X 36" conc. mon. w/brass tablet #13584

P. Pole N10°W 74.67' #7

36" Maple S36°E 43.99' #3

30" Maple S09°E 94.34' #4

6" Clump Cherry N58°E 41.47' #8

Boulder "X" in top center S44°E 47.43' #9

Newaygo Engineering and Survey Co.

Drawing No. 91347B April 8, 1992

Found R.A.G.'s conc. mon w/brass tablet #13584

P. Pole N10°W 74.72' #7

36" Maple S36°E 43.99' #3

30" Maple S09°E 94.34' #4

14" Cherry N45°E 41.48' #8