

MAR 13 2000

1999 Newaygo County Remonumentation Project

NEWAYGO COUNTY REGISTER OF DEEDS LINDA M. BROWN

SECTION

LAND CORNER RECORDATION CERTIFICATE FILING REQUIREMENT of Act 74, Mich. P.A. 1970

FEB 28 PM 1 18

For corners in Newaygo (County) Located in: Corner Code # 1. Public Land Survey T 16N R 11W I-5 2. Property Controlling in Section S T R 3. Miscellaneous Property in Sec. S T R 4. Lot No. Recorded Plat 5. Private Claims

Linda M. Brown

VOL. 2 376

Register of Deeds Stamp & File Number

Grid with columns A-M and rows 1-13. A dot is present in cell G5.

I, Norman L. Ochs, in a field survey on July 9, 1999, do hereby certify that under requirements of P. A. 74, Michigan P.A. of 1970, the corner points mentioned in lines 1 and 2 above were in conformance with regulations and rules therefore as required in the current manual of survey instructions of the United States Department of the Interior, Bureau of Land Management or by a decree of a Court of Law and/or that the corner points mentioned in lines 3, 4 and 5 above were in conformance with the rules of the Michigan Board of Land Surveyors or by a Decree of a Court of Law; established, re-established, monumented, re-monumented, recovered, found as expressed below:

Note: Not more than 4 corners, all in the same town and range, may be recorded on this certificate.

Southwest Corner, Section 11, Barton Township, Newaygo County, Michigan.

A. DESCRIPTION OF ORIGINAL MONUMENT AND ACCESSORIES AND/OR SUBSEQUENT RESTORATION:

G.L.O. Milton Nye 1856 Resurvey 10" Beech N49°W 50 Links (33')#1 20" Yellow Birch S30°E 20 Links (13.2')#2

Newaygo County Road Commission Sheet Iron in monument box 16" Cedar N41°E 48.8' #4 14" Ash N59°E 66.7' #5 Power Pole N65°W 75.5' #6

Lyle S. Shepherd R.L.S. #503 Witness Book Number 1, Page 125 White Stone N49°W 50 Links (33')#3

Robert L. Wetherell R.L.S. #24624 May 25, 1994 Recorded in Liber 359, Page 8515 Power Pole S53°E 94.64' #7 12" Ash S52°W 41.67' #8 4" White Pine N38°E 62.70' #9 Power Pole N60°W 75.88' #8

B. DESCRIPTION OF CORNER EVIDENCE FOUND AND/OR METHOD APPLIED IN RESTORING OR REESTABLISHING CORNER:

Found 1/2" x 14" Iron Pipe in monument box in the centerline of bituminous road going North and in the centerline of the East and West bituminous road. The condition of the recorded witnesses are: #1 thru #4 gone, #5 thru #8 good condition, #9 gone.

C. DESCRIPTION OF MONUMENT FOR CORNER AND ACCESSORIES ESTABLISHED TO PERPETUATE LOCATING THE POSITION OF THE CORNER:

Removed Iron Pipe and cap and set a 2 3/4" diameter Harrison cast iron monument 18" long marked "County Survey" in monument box as a substantial marker for the section corner and is accepted as a careful and faithful reestablishment of the position of the original corner.

28" Ash N57°E 67.17' Set spike with tag #22439 in Northwest side of tree. #5 Power Pole N63°W 75.95' Found spike in North side of pole. #6 Power Pole S58°E 94.65' Found spike in Northeast side of pole. #7 16" Ash S47°W 41.75' Found spike in Southeast side of tree. #8 10" White Pine N32°E 69.66' Set spike with tag #22439 in Southeast side of tree.


Signed by Norman L. Ochs Date October 22, 1999

Surveyor's Michigan License No. 22439

Form approved by Michigan State Board of Land Surveyors, Jan 28, 1971

Approved by Peer Review Group on November 30, 1999 Norman L. Ochs, County Representative.

Revised May 14, 1975 Revised Jan., 1983

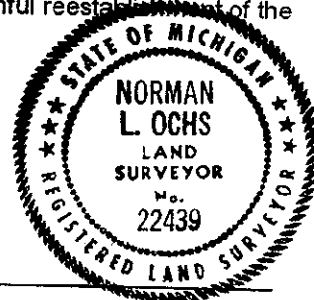

M. L. O.