

1993

1993 NEWAYGO COUNTY REMONUMENTATION PROJECT

NEWAYGO COUNTY DEEDS MARLET 1000000

COMMISSION

LAND CORNER RECORDATION CERTIFICATE

Filing Requirement of Act 74, Mich. P.A. 1970

1994 JAN 21 PM 3 29

For corners in

Newaygo (County)	Located In:	Corner Code #
1. Public Land Survey	T 16 N R 12 W	F-3
	T R	
	T R	
	T R	
2. Property Controlling in Section	S T R	
	S T R	
3. Miscellaneous Property in Sec.	S T R	
	S T R	

Marlene Toogood

VOL 001 PAGE 69

Register of Deeds Stamp & File Number

- 4. Lot No. _____, Recorded Plat _____
- 5. Private Claims _____

	A	B	C	D	E	F	G	H	I	J	K	L	M
2	6		5		4		3		2		1		
3						●							
4	7		8		9		10		11		12		
5													
6	18		17		16		15		14		13		
7													
8	19		20		21		22		23		24		
9													
10	30		29		28		27		26		25		
11													
12	31		32		33		34		35		36		
13													

I, Norman L. Ochs, in a field survey on December 11, 19 93, do hereby certify that under requirements of P.A. 74, Michigan P.A. of 1970, the corner points mentioned in lines 1 and 2 above were in conformance with regulations and rules therefore as required in the current manual of survey instructions of the United States Department of the Interior, Bureau of Land Management or by a decree of a Court of Law and/or that the corner points mentioned in lines 3, 4 and 5 above were in conformance with the rules of the Michigan Board of Land Surveyors or by a Decree of a Court of Law; established, re-established, monumented, re-monumented, recovered found as expressed below:

NOTE: Not more than 4 corners, all in the same town and range, may be recorded on this certificate.

A. Description of original monument and accessories and/or subsequent restoration:

- F-3 - N. 1/4 Corner, Sec. 9, T16N, R12W, Newaygo Co., Mi. (Home Twp.)
 - 1856 - Milton Nye, G.L.O. 1903 - William Jaques
 - #1 11" Maple S62°W 55 Links Reported bearing tree still
 - #2 24" Pine S62°E 35 Links good and reported distance of 2839.98' to NW Sec. cor.
 - 1899 - Delos Anderson, Co., Surveyor Found original corner and reported distance of 2839.32' to NW cor. of Sec. 1937 - Newaygo Co. Road Comm. 1-1/2" Gas Pipe
 - #3 18" B. Oak N49-1/4°E 101.9'
 - #4 12" B. Oak S22°E 31.5'

- 1979 - Gerald J. Gray, LS 17741 Found Gas Pipe
- #5 P. Pole AZ. 178° 54.4'
- #6 16" Oak AZ 158° 31.5'
- #7 22" Oak AZ 49° 101.5'

B. Description of corner evidence found and/or method applied in restoring or reestablishing corner:

F-3 - N. 1/4 Corner, Sec. 9, T16N, R12W, Newaygo Co., Mi.

I found 2" Pipe, 18" long with broken crockery and Glass in the intersection of roads North, East and West and in line with fence to South. I measured a distance of Northwest Section corner of 2837.4' consistent with surveyors Anderson and Jaques. Condition of the recorded witnesses are: #1 Gone, #2 Gone, #3 Found in good condition, #4 Found 12' high stump, #5 Found in good condition, #6 Found 12' high stump, #7 Found in good condition.


C. Description of monument for corner and accessories established to perpetuate locating the position of the corner:

F-3 - N. 1/4 Corner, Sec. 9, T16N, R12W, Newaygo Co., Mi.

I replaced the 2" pipe with a 4" diameter Harrison Cast Iron Monument and is accepted as a careful and faithful perpetuation of the position of the original corner.

- P. Pole S2°E 54.44' (Found R.L.S. Tax 13584 in East side)
- 28" B. Oak N54°E 102.04' (Set 60d spike in SE side) (O.B.T. #3 & #7)
- 7" W. Oak N87°E 142.16' (Set 60d spike in South side)
- 7" B. Oak N14°W 210.90' (Set 60d spike in West side)
- 19" B. Oak (top broken out) S20°E 31.49' (Found nail in East side) (O.B.T. #4 & #6)

Signed by Norman L. Ochs Date DEC 21, 1993
 Surveyor's Michigan License No. LS 22439

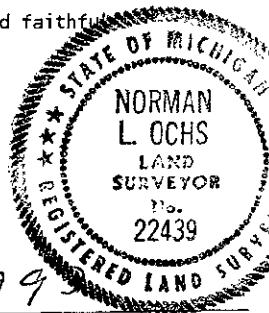

Approved by Peer Review Group Dec. 21, 1993
 Norman Ochs, County Representative