

**SURVEY &
REMONUMENTATION**

MAR 19 1998

1997 Newaygo County Remonumentation Project

NEWAYGO COUNTY
REGISTER OF DEED
LINDA M. BROWN

'98 MAR 6 PM 12

**LAND CORNER RECORDATION CERTIFICATE
FILING REQUIREMENT of Act 74, Mich. P.A. 1970**

SECTION

For corners in <u>Newaygo</u> (County)	Located in:	Corner Code #
1. Public Land Survey	T <u>16N</u> R <u>12W</u>	<u>G-6</u>
	T ___ R ___	_____
	T ___ R ___	_____
	T ___ R ___	_____
2. Property Controlling in Section	S ___ T ___ R ___	_____
	S ___ T ___ R ___	_____
3. Miscellaneous Property in Sec.	S ___ T ___ R ___	_____
	S ___ T ___ R ___	_____
4. Lot No. _____, Recorded Plat _____		
5. Private Claims _____		

Linda M. Brown

VOL. 2

147

Register of Deeds Stamp & File Number

	A	B	C	D	E	F	G	H	I	J	K	L	M
1													
2	6	5	4	3	2	1							
3													
4	7	8	9	10	11	12							
5													
6	18	17	16	15	14	13							
7													
8	19	20	21	22	23	24							
9													
10	30	29	28	27	26	25							
11													
12	31	32	33	34	35	36							
13													

I, Norman L. Ochs, in a field survey on August 8, 19 97, do hereby certify that under requirements of P. A. 74, Michigan P.A. of 1970, the corner points mentioned in lines 1 and 2 above were in conformance with regulations and rules therefore as required in the current manual of survey instructions of the United States Department of the Interior, Bureau of Land Management or by a decree of a Court of Law and/or that the corner points mentioned in lines 3, 4 and 5 above were in conformance with the rules of the Michigan Board of Land Surveyors or by a Decree of a Court of Law; established, re-established, monumented, re-monumented, recovered, found as expressed below:

Note: Not more than 4 corners, all in the same town and range, may be recorded on this certificate.

West One Quarter Corner, Section 15, Home Township, Newaygo County, Michigan

A. DESCRIPTION OF ORIGINAL MONUMENT AND ACCESSORIES AND/OR SUBSEQUENT RESTORATION:

G.L.O. Milton Nye Resurvey 1856
11" Maple N53°W 20 Links (13.2') #1
8" Beech S68°E 8 Links (5.28') #2

Newaygo County Road Commission Sheet
Plow Point
Fence Post N89°E 32.7' #3
Fence Post N88°W 34.2' #4
10" Pine S36°W 79.2' #5

George H. Johnson R.L.S. #504
Plow Point LCRC #414 1919
No Witnesses

Robert A. Griffin R.L.S. #13584
LCRC #414 June 7, 1977
Found the Plow Point by George H. Johnson.
Power Pole N89°E 82.31' #7
3" White Pine N35°W 47.92' #6
4" X 7' Post West 33.34' #8

Robert L. Wetherell R.L.S. #24624
December 2, 1994 Found Robert A. Griffin monument badly damaged.
Replaced with 1/2" Rod and cap #24624
4" X 4" Post West 33.34' #4
Power Pole N89°E 82.31' #5
8" Jack Pine S49°W 44.35' #9

B. DESCRIPTION OF CORNER EVIDENCE FOUND AND/OR METHOD APPLIED IN RESTORING OR REESTABLISHING CORNER:

Found 1/2" rod and cap #24624 and the centerline of the North and South gravel road is 6 feet West and the centerline of the North and South fence is 34 feet West and old fence on ground going East is 2.5 feet North. The condition of the recorded witnesses are: #1 and #2 gone, #3 bent, #4 gone, #5 stump, #6 dead, stump, #7 thru #9 good condition.

C. DESCRIPTION OF MONUMENT FOR CORNER AND ACCESSORIES ESTABLISHED TO PERPETUATE LOCATING THE POSITION OF THE CORNER:

Removed 1/2" rod and cap and set a 4" diameter Harrison cast iron monument 20" long marked "County Surveyor" as a substantial marker for the section corner and is accepted as a careful and faithful reestablishment of the original corner.

16" Pine Stump S36°W 79.2' to face. #5
4" Pine dead Stump N35°W 47.95' Found nail in Northeast side of stump. #6
Power Pole N87°E 82.24' Found RAG tag in North side of pole. #7
4" X 4" Post West 33.30' Found nail in South side of post. #8
10" Jack Pine S49°W 44.30' Found nail in East side of tree. #9
4" Maple N37°W 47.95' Set spike in Southwest side of tree.
Northwest Corner House S40°E 201.53'


Signed by Norman L. Ochs
Norman L. Ochs

Date September 8, 1997

Surveyor's Michigan License No. 22439

Form approved by Michigan State Board of Land Surveyors, Jan 28, 1971
Revised May 14, 1975
Revised Jan., 1983

Approved by Peer Review Group on September 9, 1997
Norman L. Ochs, County Representative.

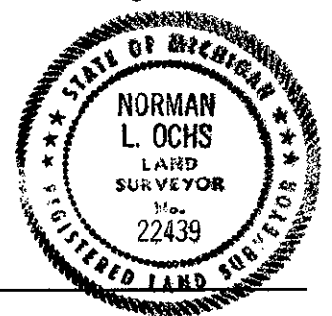

N.L.O.