

**SURVEY & REMONUMENTATION**  
 1995 Newaygo County Remonumentation Project

APR 04 1996

**LAND CORNER RECORDATION CERTIFICATE**  
 FILING REQUIREMENT of Act 74, Mich. P.A. 1970

VOL. 1 PAGE 200

NEWAYGO COUNTY  
 REGISTER OF DEEDS

FEB 21 AM 9 43

*Morlene Toogood*

**Register of Deeds Stamp & File Number**

	A	B	C	D	E	F	G	H	I	J	K	L	M
2	6	5	4	3	2								
3													
4	7	8	9	10	11	12							
5													
6	10	17	16	15	14	13							
7													
8	19	20	21	22	23	24							
9													
10	30	29	28	27	26	25							
11													
12	31	32	33	34	35	36							
13													

For corners in COMMISSION  
Newaygo (County) Located in: Corner Code #

1. Public Land Survey  
 T 16N R 11W  
 T 16N R 12W  
 T \_\_\_\_\_ R \_\_\_\_\_  
 T \_\_\_\_\_ R \_\_\_\_\_

2. Property Controlling in Section  
 S \_\_\_\_\_ T \_\_\_\_\_ R \_\_\_\_\_  
 S \_\_\_\_\_ T \_\_\_\_\_ R \_\_\_\_\_

3. Miscellaneous Property in Sec.  
 S \_\_\_\_\_ T \_\_\_\_\_ R \_\_\_\_\_  
 S \_\_\_\_\_ T \_\_\_\_\_ R \_\_\_\_\_

4. Lot No. \_\_\_\_\_, Recorded Plat \_\_\_\_\_  
 5. Private Claims \_\_\_\_\_

I, Norman L. Ochs, in a field survey on December 6, 1995, do hereby certify that under requirements of P. A. 74, Michigan P.A. of 1970, the corner points mentioned in lines 1 and 2 above were in conformance with regulations and rules therefore as required in the current manual of survey instructions of the United States Department of the Interior, Bureau of Land Management or by a decree of a Court of Law and/or that the corner points mentioned in lines 3, 4 and 5 above were in conformance with the rules of the Michigan Board of Land Surveyors or by a Decree of a Court of Law; established, re-established, monumented, re-monumented, recovered, found as expressed below:

**Note: Not more than 4 corners, all in the same town and range, may be recorded on this certificate.**

W. 1/4 Corner, Section 18, Barton Twp., Newaygo Co., MI  
 E. 1/4 Corner, Section 13, Home Twp., Newaygo Co., MI

**A. DESCRIPTION OF ORIGINAL MONUMENT AND ACCESSORIES AND/OR SUBSEQUENT RESTORATION:**

G.L.O. John Hodson 1838 8" Pine S44°W 6 Lks (3.96') #1 10" Hemlock N15°W 35 Lks (23.10') #2	Lye S. Shepherd's Witness Book No. 1 Pg. 124 30" Pine Stp. S82 1/2°E 59' #5 5" Maple N75°W 39 1/2' #6
Lye S. Shepherd RLS #503 Book 36 Pg. 94 1916 Found brick and old stake 24" P. Stp. N32 1/4°W 50' #3 8" P. Stp. S86°W 8.0' #4 Measured 2608 ft from the S.W. Cor. to the W. 1/4 Cor. of Sec. 18 and measured 2644 ft from the W. 1/4 Cor. to the N.W. Cor. of Sec. 18	NCRC Sheet Brick and wood stake 24" P. Stp. N32°W 50.0' #3 8" P. Stp. S86°W 8.0' #4 Measured 2608.0 ft from the S.W. Cor. to the W. 1/4 Cor. of Sec. 18 and Measured 2644 ft from te W. 1/4 Cor. to the N.W. Cor. of Sec. 18

Newaygo Engineering and Survey Co.  
 Drawing No. 94158B September 1, 1994  
 Found 1/2" rod  
 P. Pole S88°E 49.72' #7  
 1/2" rod and cap East 33.00' #8  
 20" W. Pine N85°W 58.84' #9  
 10" W. Pine N60°W 51.75' #10

**B. DESCRIPTION OF CORNER EVIDENCE FOUND AND/OR METHOD APPLIED IN RESTORING OR REESTABLISHING CORNER:**

Found 1/2" rod and the centerline of the N & S gravel road is 9 ft West and measured 2632.84 ft from the N.W. Cor. to the W. 1/4 Cor. of Sec. 18 and measured 2606.35 ft from the W. 1/4 Cor. to the S.W. Cor. of Sec. 18. and the condition of the recorded witnesses are: #1 thru #6 gone, #7 thru #10 good condition.

**C. DESCRIPTION OF MONUMENT FOR CORNER AND ACCESSORIES ESTABLISHED TO PERPETUATE LOCATING THE POSITION OF THE CORNER:**


Removed 1/2" rod and set a 4" dia. Harrison cast iron monument 20" long marked "County Surveyor" as a substantial marker for the section corner and is accepted as a careful and faithful reestablishment of the original corner.

P. Pole S88°E 49.72' Spike on South side of pole. #7  
 1/2" rod and cap East 33.00' #8  
 20" W. Pine N85°W 58.84' Spike on South side of tree. #9  
 10" W. Pine N60°W 51.75' Spike on Northeast side of tree. #10

Signed by Norman L. Ochs Date December 12, 1995  
 Surveyor's Michigan License No. 22439

Approved by Peer Review Group On December 13, 1995  
 Norman L. Ochs, County Representative.

*N.L.O.*

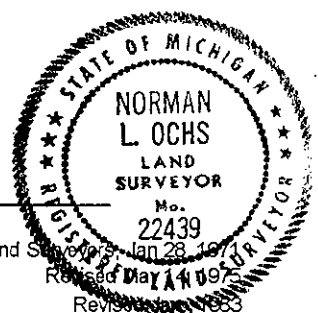

 Revised July 1, 1983