

SURVEY & REMONUMENTATION

MAR 19 1998

1997 Newaygo County Remonumentation Project

NEWAYGO COUNTY REGISTER OF DEEDS LINDA M. BROWN

'98 MAR 6 PM 12 3

SECTION

LAND CORNER RECORDATION CERTIFICATE FILING REQUIREMENT of Act 74, Mich. P.A. 1970

Linda M. Brown

For corners in Newaygo (County) Located in: Corner Code #

1. Public Land Survey T 16N R 13W G-3
 T _____ R _____
 T _____ R _____
 T _____ R _____

2. Property Controlling in Section S _____ T _____ R _____
 S _____ T _____ R _____

3. Miscellaneous Property in Sec. S _____ T _____ R _____
 S _____ T _____ R _____

4. Lot No. _____, Recorded Plat _____

5. Private Claims _____

VOL. 2

144

Register of Deeds Stamp & File Number

	A	B	C	D	E	F	G	H	I	J	K	L	M
1													
2	6	5	4	3	2	1							
3													
4	7	8	9	10	11	12							
5													
6	18	17	16	15	14	13							
7													
8	19	20	21	22	23	24							
9													
10	30	29	28	27	26	25							
11													
12	31	32	33	34	35	36							
13													

I, Norman L. Ochs, in a field survey on September 27, 1997, do hereby certify that under requirements of P. A. 74, Michigan P.A. of 1970, the corner points mentioned in lines 1 and 2 above were in conformance with regulations and rules therefore as required in the current manual of survey instructions of the United States Department of the Interior, Bureau of Land Management or by a decree of a Court of Law and/or that the corner points mentioned in lines 3, 4 and 5 above were in conformance with the rules of the Michigan Board of Land Surveyors or by a Decree of a Court of Law; established, re-established, monumented, re-monumented, recovered, found as expressed below:

Note: Not more than 4 corners, all in the same town and range, may be recorded on this certificate.

Southwest Corner, Section 3, Lilley Township, Newaygo County, Michigan.

A. DESCRIPTION OF ORIGINAL MONUMENT AND ACCESSORIES AND/OR SUBSEQUENT RESTORATION:

G.L.O. Thomas Whelpley Resurvey 1856
 Set Post
 12" Yellow Pine N42½°E 6 Links (3.96') #1
 14" Yellow Pine S32°E 25 Links (16.5') #2
 18" Yellow Pine N57¼°W 30 Links (19.8') #3

Ralph A. Smith R.L.S. #3421
 Book 81 Page 44 May 3, 1961
 Found 4" Square Wood Stake and ½" Gas Pipe
 Southwest Corner House N50°E 202.7' #4
 12" White Oak S05°E 18.5' #5
 4" Maple N40°W 12.7' #6
 4" Maple N40°E 21.8' #7

Delos G. Anderson (County Surveyor)
 Book A Pages 295 and 296
 April 26 to May 14, 1900
 Old Government Corner Witness there.

OVER ↵


B. DESCRIPTION OF CORNER EVIDENCE FOUND AND/OR METHOD APPLIED IN RESTORING OR REESTABLISHING CORNER:

Found ½" X 20" Iron Pipe over pointed wood post, broken off at grade, 26" long, 4"± diameter at top with two stones (G.L.O Post) also large stone 3'± below grade (possible G.L.O. Post). The condition of the recorded witnesses are: #1 stump, #2 stump hole, #3 stump, #4 thru #11 good condition.

C. DESCRIPTION OF MONUMENT FOR CORNER AND ACCESSORIES ESTABLISHED TO PERPETUATE LOCATING THE POSITION OF THE CORNER:

Removed ½" X 20" Iron Pipe, Pointed Wood Post and two stones and set 4" diameter Harrison cast iron monument 36" long over large stone, marked "County Surveyor" as a substantial marker for the section corner and is accepted as a careful and faithful perpetuation of the original corner.

- 16" Stump, 30" tall with blaze N37°E 4' to face. #1
- Stump hole, depression in ground S22°E 16.15' #2
- 12" Stump, 12" tall (decayed) N57°W 20' #3
- Southwest Corner Log Cabin N50°E 202.19' #4
- 20" White Oak S05°E 18.93' Set spike and tag in West side of tree. #5
- 8" Maple with blaze N38°W 12.53' to face. #6
- 10" Maple with blaze N37°E 21.70' to center. #7
- 12" Red Oak S32°E 38.55' Found spike in Easterly side of tree. #8
- 10" Maple S45°W 27.33' Found spike in East side of tree. #9
- 4"-6" Twin Maple N57°W 35.85' Found spike in North side of tree. #10
- 6" Maple N16°W 27.10' Found spike in East side of tree. #11

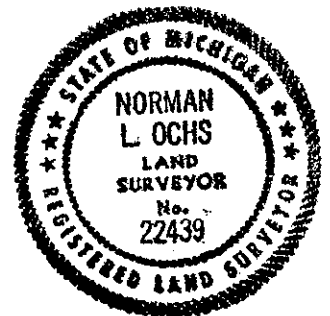

Signed by Norman L. Ochs Date October 7, 1997

Surveyor's Michigan License No. 22439

Form approved by Michigan State Board of Land Surveyors, Jan 28, 1971

Approved by Peer Review Group on December 18, 1997

Norman L. Ochs, County Representative.

Revised May 14, 1975

Revised Jan., 1983

NLO

A. Description (cont.)

Robert L. Wetherell R.L.S. #24624

May 29, 1995 1/2" Iron Pipe

10" Red Oak S34°E 38.55' #8

8" Maple S39°W 27.35' #9

8" Maple N57°W 35.88' #10

5" Maple N12°W 27.12' #11