

COMMISSION

LAND CORNER RECORDATION CERTIFICATE Filing Requirement of Act 74, Mich. P.A. 1970

JAN 21 PM 3 28 Marlene Toogood

For corners in

Table with columns: NEWAYGO (County), Located In: (Town/Range/Section), Corner Code #. Includes entries for Public Land Survey, Property Controlling in Section, and Miscellaneous Property in Sec.

VOL 001 PAGE 56

Register of Deeds Stamp & File Number

- 4. Lot No. , Recorded Plat
5. Private Claims

Grid table with columns A-M and rows 2-13, containing numbers 1-36.

I, Norman L. Ochs, in a field survey on December 5, 1993, do hereby certify that under requirements of P.A. 74, Michigan P.A. of 1970, the corner points mentioned in lines 1 and 2 above were in conformance with regulations and rules therefore as required in the current manual of survey instructions of the United States Department of the Interior, Bureau of Land Management or by a decree of a Court of Law and/or that the corner points mentioned in lines 3, 4 and 5 above were in conformance with the rules of the Michigan Board of Land Surveyors or by a Decree of a Court of Law; established, re-established, monumented, re-monumented, recovered, found as expressed below:

NOTE: Not more than 4 corners, all in the same town and range, may be recorded on this certificate.

N.W. Corner, Sec. 18, Troy Twp.

A. Description of original monument and accessories and/or subsequent restoration:

- GLO 1856 T. Whelpley Monument - Wood Stake
18" Sugar N23°E 34 lks #1
22" Sugar S82°E 34 lks #2 (RLS #503) #1
Lyle Shepherd's Witness Book
14" Sugar S21°W 147' #3
1968 George Blass #5489 Iron Fd.
10" Maple S38°E 36.26' #4
T. Pole S43°W 38.41' #5
T. Pole N5°W 133.32' #6
USFS Post N51°W 35.43' #7
NCRC Sheet 1/2" Bolt
Cor Post NW 38.7' #7
Cor Post NE 37.6' #8


- 1969 Robert A. Griffin #13584 Set 5' x 36" conc. mon w/brass cap
4" Cherry N55°E 85.37' #9
6" R. Pine S56°W 81.33' #10
S.E. Cor. Conc. slab N80°W 171.74' #11
14" Maple S84°E 105.82' #12
LCRC #642

B. Description of corner evidence found and/or method applied in restoring or reestablishing corner:

In 1969 Robert A. Griffin found iron that George Blass found in 1968. He replaced it with a 5" x 36" conc. mon w/brass cap. He measured 2638.04 feet from the NW cor. of Sec. 18 to the W. 1/4 Cor. of Sec. 7 and 2722.72 feet to the N. 1/4 Cor of Sec. 18. N. L. Ochs in 1993 found R. A. Griffins monument w/brass cap in good condition. Condition of recorded witnesses is: #1 thru #3 gone, #4 good, #5 & 6 gone, #7 good condition, #8 gone, #9 thru #12 good condition.

C. Description of monument for corner and accessories established to perpetuate locating the position of the corner:

Accepted R. A. Griffin's monument w/brass cap as a substantial marker for the Section corner and is accepted as a careful and faithful re-establishment of the position of the original corner. 8" Cherry N55°E 85.35' Spike in NW side of tree #9. 10" R. Pine S56°W 81.31' Spike in Easterly side of tree #10. SE Cor. conc. slab N80°W 171.74' #11. 14" Maple S84°E 105.82' Spike in South side of tree #12. Cor. Post NW 38.09' Spike in Northerly side of Post #7. 18" Maple S40°E 36.42' Spike in Westerly side of tree #4.

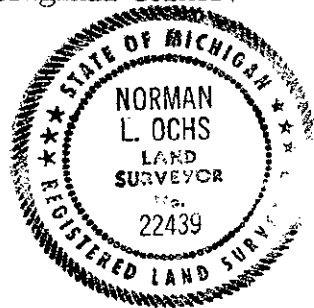

Signed by Norman L. Ochs Date December 20, 1993
Surveyor's Michigan License No. 22439

Approved by Peer Review Group Dec. 21, 1993
Norman L. Ochs, County Representative