

SURVEY &  
REMONUMENTATION

LIBER 19350PG368

1JA-599001668

MAR 11 1999

LAND CORNER RECORDATION CERTIFICATE  
Filing Requirement of Act 74, Mich. P.A. 1970

\$ 7.00 MISCELLANEOUS RECORDING  
\$ 2.00 REMONUMENTATION  
3 JAN 99 8:24 A.M. RECEIPT# 8A  
PAID RECORDED - OAKLAND COUNTY  
G. WILLIAM CADDELL  
CLERK/REGISTER OF DEEDS

For corners in SECTION

| Oakland<br>(County)                   | Located in: Lyon<br>Township | Corner Code # |
|---------------------------------------|------------------------------|---------------|
| 1. Public Land Survey                 | T <u>1N</u> R <u>7E</u>      | <u>A-2</u>    |
|                                       | T _____ R _____              | _____         |
|                                       | T _____ R _____              | _____         |
|                                       | T _____ R _____              | _____         |
| 2. Property Controlling<br>in Section | S _____ T _____ R _____      | _____         |
|                                       | S _____ T _____ R _____      | _____         |
| 3. Miscellaneous<br>Property in Sec.  | S _____ T _____ R _____      | _____         |
|                                       | S _____ T _____ R _____      | _____         |

Compliance with  
ACT 345, P.A. 1990  
APPROVED ON: 12-21-98 JS  
OAKLAND COUNTY REMONUMENTATION  
PEER GROUP COMMITTEE  
Register of Deeds Stamp & File Number

4. Lot No. \_\_\_\_\_, Recorded Plat \_\_\_\_\_  
5. Private Claims \_\_\_\_\_

I, Bruce Antcliff, in a field survey on December 14 19 98, do hereby certify that under requirements of P.A. 74 Michigan P.A. of 1970, the corner points mentioned in lines 1 and 2 above were in conformance with regulations and rules therefore as required in the current manual of survey instructions of the United States Department of the interior, Bureau of Land Management or by a decree of a Court of Law and/or that the corner points mentioned in lines 3, 4 and 5 above were in conformance with the rules of the Michigan Board of Land Surveyors or by a Decree of a Court of Law; established, re-established, monumented, re-monumented, recovered, found as expressed below:

NOTE: Not more than 4 corners, all in the same town and range, may be recorded on this certificate.

A. Description of original monument and accessories and/or subsequent restoration:

A-2 This corner was not originally set by the G.L.O.  
N/A N/A O.C. Tax Maps N/A

Records indicate this corner is not common with M-2, T1N, R6E.

B. Description of corner evidence found and/or method applied in restoring or reestablishing corner:

A-2 Found a pointed stone on line of the remains of a fence line and tree row running North and South and 314.50' South of Livingston County Monument (M-2, T1N, R6E, as referenced in L.C. L.S.C. #823m Livingston County Records). Meas. South 2338.00' to M-3, T1N, R6E. Boss Survey (1997) = 2337.74. The found pointed stone is on the Township line.

Measure North 2968.0' to M-1, T1N, R6E (MDOT (1966 ±) = 2972.71') (Boss (1997) = 2967.86')  
Measure South 2586.36' to A-3  
Measure North 314.5' to M-2, T1N, R6E (Boss (1997) = 315.06')

C. Description of monument for corner and accessories established to perpetuate locating the position of the corner:

A-2 Replaced the stone with a concrete monument with brass cap stamped "Oakland County Remonumentation P.S. #25826."


PK Nail & Oakland Co. Remonumentation Tag #25854 in E Side 12" Oak N 00° E 12.13'  
PK Nail & Oakland Co. Remonumentation Tag #25854 in SE Side 18" Oak N 45° E 14.18'  
PK Nail & Oakland Co. Remonumentation Tag #25854 in E Side 8" Oak S 05° E 23.29'  
PK Nail & Oakland Co. Remonumentation Tag #25854 in S Side 8" Oak N 90° W 18.80'  
Livingston County Mon., M-2, T1N, R6E, North 314.50'

The selected location is accepted by the Contractor and is generally accepted by professional surveyors as the best available evidence of the position of the original corner.

Signed by Bruce Antcliff  
EARTH TECH

Date 12-24-98

Surveyor's Michigan License No. 25826

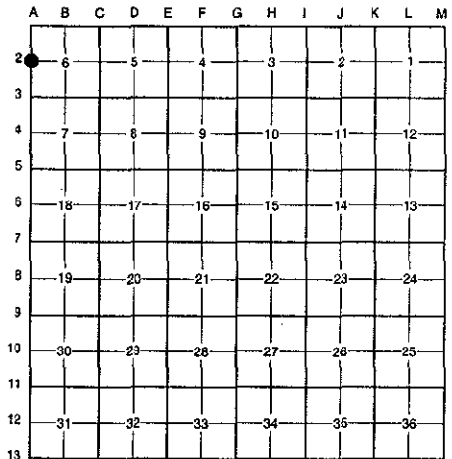

7.00 FILE  
2.00

