

SURVEY & RECORDS
1935010874

JA-599001673

LAND CORNER RECORDATION CERTIFICATE
Filing Requirement of Act 74, Mich. P.A. 1970

\$ 9.00 MISCELLANEOUS RECORDING
\$ 2.00 REMONUMENTATION
3 JAN 99 8:24 A.M. RECEIPT BA
PAID RECORDED - OAKLAND COUNTY
G. WILLIAM CARDELL
CLERK/REGISTER OF DEEDS

Compliance with
ACT 345, P.A. 1990
APPROVED ON: 12-16-98 Jc
OAKLAND COUNTY REMONUMENTATION
PEER GROUP COMMITTEE
Register of Deeds Stamp & File Number

For corners in

Oakland (County)	SECTION	Located in: Lyon Township	Corner Code #
1. Public Land Survey	T <u>1N</u> R <u>7E</u>		<u>A-7</u>
	T _____ R _____		_____
	T _____ R _____		_____
	T _____ R _____		_____
2. Property Controlling in Section	S _____ T _____ R _____		_____
	S _____ T _____ R _____		_____
3. Miscellaneous Property in Sec.	S _____ T _____ R _____		_____
	S _____ T _____ R _____		_____

4. Lot No. _____, Recorded Plat _____
5. Private Claims _____

I, Bruce Antcliff, in a field survey on June 16 19 98, do hereby certify that under requirements of P.A. 74 Michigan P.A. of 1970, the corner points mentioned in lines 1 and 2 above were in conformance with regulations and rules therefore as required in the current manual of survey instructions of the United States Department of the interior, Bureau of Land Management or by a decree of a Court of Law and/or that the corner points mentioned in lines 3, 4 and 5 above were in conformance with the rules of the Michigan Board of Land Surveyors or by a Decree of a Court of Law; established, re-established, monumented, re-monumented, recovered, found as expressed below:

NOTE: Not more than 4 corners, all in the same town and range, may be recorded on this certificate.

A. Description of original monument and accessories and/or subsequent restoration:

A-7	1816	Holmes	G.L.O.	Set Post
	1935	Baldwin	Survey	N/A
	1989	Boss	Survey L. 11156 P. 251	N/A

(Continued on Back)

Records indicate this corner is not common with M-7, T1N, R6E.

B. Description of corner evidence found and/or method applied in restoring or reestablishing corner:

A-7 Found a capped iron #30096 in the approximate C/L of railroad running Northwest-Southeast on the C/L ± of 11 Mile Road (gravel) running East and approximately 6' East of the C/L of Dixboro Road (gravel) running North per 1992 H. Munzel survey. Found iron is 166.48' South of the Livingston County monument at M-7, T1N, R6E, as set in the L.C.R.C. L.S.C. #469m (Livingston County Records). Checks the following witnesses:

Unrecorded Survey (1992)	Unrecorded Survey (1993)
N 5° W 77.7' Nail W Side P. Pole (m. 77.98')	N 5° W 77.75' Nail W/S P. Pole (m. 77.98')
S 80° E 68.6' Nail W Side P. Pole (m. 68.69')	Due West 55.64' Nail N/S P. Pole (m. 55.53')
N 75° E 101.7' 2" Dia. Steel Post Street Sign (m. 101.67')	S 80° E 68.68' Nail W/S P. Pole (m. 68.69')
S 45° E 11.9' Center (Split) of RR Tie Dr. Crossing (m. 11.9')	N 75° E 101.71' C/L Dixboro Road & Eleven Mile Sign (m. 101.67')

Measure North 2655.3' to A-6 (Munzel Survey (1992) = 2655.03')(Baldwin = 2590.77')

Measure South 2614.7' to A-8

Measure East 1508.96' to B-7 (G.L.O. = 1512.06')

Measure North 166.48' to M-7, T1N, R6E (G.L.O. = 166.98')

C. Description of monument for corner and accessories established to perpetuate locating the position of the corner:

A-7 Replaced the capped iron with a 5/8" x 24" rebar with brass cap stamped "Oakland County Remonumentation P.S. #25826."


- PK Nail & Oakland Co. Remonumentation Tag in W. Side P. Pole N 12° W 77.98'
- PK Nail & Oakland Co. Remonumentation Tag in N Side P. Pole S 63° W 55.53'
- PK Nail & Oakland Co. Remonumentation Tag in W Side P. Pole S 66° E 68.69'
- PK Nail & Oakland Co. Remonumentation Tag in C/L Street Sign Dixboro & 11 Mile N 70° E 101.67'
- PK Nail & Oakland Co. Remonumentation Tag in S'y Side 8" Ash 5' +/- Above Gnd. N 49° E 102.02'

The selected location is accepted by the Contractor and is generally accepted by professional surveyors as the best available evidence of the position of the original corner.


igned by Bruce Antcliff Date 12-22-98

EARTH TECH

urveyor's Michigan License No. 25826

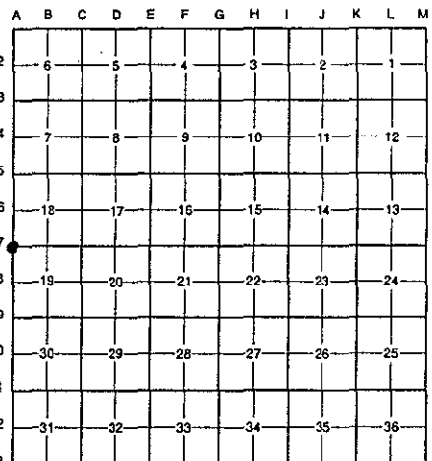

920 FILE
200

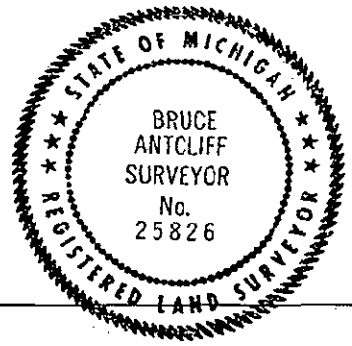

SURVEY &
REMONUMENTATION

MAR 11 1999

LIBER 19350PG875

SECTION

A. Description of original monument and accessories and/or subsequent restoration:

A-7	1992	Munzel	Survey	1/2" Sq. Hd. Bolt in R.R. Tie
	1993	Munzel	Survey	1/2" Sq. Hd. Bolt in R.R. Tie
	1993	Kostecke	Survey	N/A
	1993	G. Boss	Survey	P.K. Nail
	1993	Munzel	Survey	1/2" Sq. Hd. Bolt in R.R. Tie
	1995	B. Boss	L.C.R.C. L.S.C. #469m	L.C. Monument
	N/A	N/A	O.C. Tax Maps	N/A