

MAR 1 1999

LAND CORNER RECORDATION CERTIFICATE
Filing Requirement of Act 74, Mich. P.A. 1970

For corners in SECTION

Table with columns: County (Oakland), Located in: Lyon Township, Corner Code # (A-9), and rows for Public Land Survey, Property Controlling in Section, and Miscellaneous Property in Sec.

MISCELLANEOUS RECORDING \$ 7.00
REMONUMENTATION \$ 2.00
5 JAN 99 8:25 A.M. RECEIPT# BA
PAID RECORDED - OAKLAND COUNTY
G.WILLIAM CADRELL
CLERK/REGISTER OF DEEDS
Compliance with ACT 345, P.A. 1990
APPROVED ON: 12-16-98 JJ
OAKLAND COUNTY REMONUMENTATION
PEER GROUP COMMITTEE
Register of Deeds Stamp & File Number

4. Lot No. , Recorded Plat
5. Private Claims

I, Bruce Antcliff, in a field survey on June 17 19 98, do hereby certify that under requirements of P.A. 74 Michigan P.A. of 1970, the corner points mentioned in lines 1 and 2 above were in conformance with regulations and rules therefore as required in the current manual of survey instructions of the United States Department of the interior, Bureau of Land Management or by a decree of a Court of Law and/or that the corner points mentioned in lines 3, 4 and 5 above were in conformance with the rules of the Michigan Board of Land Surveyors or by a Decree of a Court of Law; established, re-established, monumented, re-monumented, recovered, found as expressed below:

NOTE: Not more than 4 corners, all in the same town and range, may be recorded on this certificate.

A. Description of original monument and accessories and/or subsequent restoration:

Table with columns: Corner Code (A-9), Description (1816 Holmes G.L.O., 1978 Butterfield Survey, 1978 Roskely Cert. Survey L. 7478 P. 325, Cond. Plan 259, 1978 Butterfield L.C.R.C. L. 7368 P. 328, 1978 Butterfield L.C.R.C. L.C.S. #1118, N/A N/A O.C. Tax Maps), and Monument Type (Set Post, 1/2" Pipe, N/A, Plowshare, 1" x 1/4" Strap Iron, N/A)

Records indicate this corner is not common with M-9, T1N, R6E.

B. Description of corner evidence found and/or method applied in restoring or reestablishing corner:

A-9 Found a 1/2" rebar 2.5' West of the C/L of Dixboro Road (gravel) running North and South. The found rebar is 73.27' South of the Livingston County monument at the NE corner of Sec. 25, T1N, R6E. The found rebar is 0.35' West of line between M-9 and M-10, T1N, R6E, and checks surveys and L.C.R.C.'s from 1978 to the present. Also checks the following witnesses:

- L.C.R.C. L. 7368 P. 328 (1978)
S 20° W (46.28') to PK Nail 14" Oak (m. 46.72')
N 45° E 30.2' to 2" Steel Fence Post (m. 30.05')
N 30° W 38.4' to 14" Cedar (m. 38.25')
North 73.26' 1" x 1/4" Strap Iron Surrounded by Broken Brick NE Cor. of Sec. 25 1N-R6E (m. 73.27' to L.C. Mon.)

- Measure North 2614.94' to A-8
Measure South 2644.6' to A-10 (Butterfield Survey (1978) = 2644.56')
Measure East 1456.82' to B-9 (G.L.O. = 1452.0') (Butterfield Survey (1978) = 1456.33' to TL)
Measure North 73.27' to M-9, T1N, R6E (G.L.O. = 71.94')

C. Description of monument for corner and accessories established to perpetuate locating the position of the corner:

A-9 Replaced the 1/2" rebar with a 5/8" x 24" rebar with brass cap stamped "Oakland County Remonumentation P.S. #25826."


- PK Nail & Oakland Co. Remonumentation Tag in E Side 18" Oak S 20° W 46.72'
Steel Fence Post N 45° E 30.05'
PK Nail & Oakland Co. Remonumentation Tag in NW Side 14" Cedar n 30° E 38.25'
PK Nail & Oakland Co. Remonumentation Tag in W Side 8" Walnut S 23° E 52.68'
PK Nail & Oakland Co. Remonumentation Tag in NE'ly Side 8" Basswood N 39° W 31.29'

The selected location is accepted by the Contractor and is generally accepted by professional surveyors as the best available evidence of the position of the original corner.

Signed by Bruce Antcliff

Date 12-22-98

Surveyor's Michigan License No. 25826

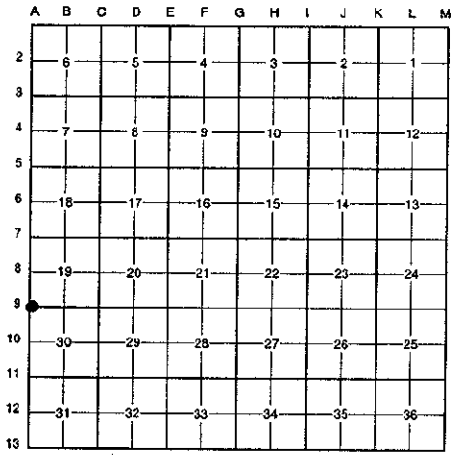

700 FILE
200

