

MAR 11 1999

LIBER 19296 PG 533

LAND CORNER RECORDATION CERTIFICATE
Filing Requirement of Act 74, Mich. P.A. 1970

SECTION

For corners in

Form with fields for location (Oakland County), Township (Lyon), Corner Code (# A-10), and survey details (Public Land Survey, Property Controlling, etc.)

Stamp area containing recording fees (\$7.00, \$2.00), date (17 DEC 98), time (3:30 P.M.), and official name (G. WILLIAM CADDELL, CLERK/REGISTER OF DEEDS)

I, Bruce Antcliff, in a field survey on July 22, 1998, do hereby certify that under requirements of P.A. 74 Michigan P.A. of 1970, the corner points mentioned in lines 1 and 2 above were in conformance with regulations and rules therefor as required in the current manual of survey instructions of the United States Department of the Interior, Bureau of Land Management or by a decree of a Court of Law and/or that the corner points mentioned in lines 3, 4 and 5 above were in conformance with the rules of the Michigan Board of Land Surveyors or by a Decree of a Court of Law; established, re-established, monumented, re-monumented, recovered, found as expressed below:

NOTE: Not more than 4 corners, all in the same town and range, may be recorded on this certificate.

A. Description of original monument and accessories and/or subsequent restoration:

A-10 This corner was not originally set by the G.L.O.

Table listing survey details: 1978 Butterfield Cert. Survey L. 7368 P. 320 N/A; 1978 Butterfield L.C.R.C. L. 7368 P. 327 Conc. Monument; 1978 Butterfield L.C.R.C. L.C.S. #1119 3/4" x 18" Iron Pipe; 1995 B. Boss L.C.R.C. L.S.C. #47lm Brass Cap in 30" Pipe; N/A N/A O.C. Tax Maps N/A

Records indicate this corner is not common with M-10, T1N, R6E.

B. Description of corner evidence found and/or method applied in restoring or reestablishing corner:

A-10 Found a concrete monument, as set by A. Butterfield at the midpoint W/L of Section 30, 3' West of the C/L of Dixboro Road (gravel) running North and South, on line of a fence line running East. The found concrete monument is within 0.2' of midpoint of W/L of Section 30 and 0.20' East of line between M-10 and M-11. The found monument checks survey and L.C.R.C. L. 7368 P.327. Also checks the following witnesses:

- L.C.R.C. L. 7368 P. 327 (1978)
S 35° E 43.56' to P.K. Nail in P. Pole (m. 43.65')
S 20° W 60.87' to P.K. Nail in 10" B. Walnut (60.94')
South 18.22' 3/4" Iron Pipe - Used as West 1/4 Cor. by Fox (m. 18.18')
North 57.02' 1" Iron Pipe - East 1/4 Cor. Sec. 25, T1N, R6E (m. 56.63' to L.C. Mon.)

Measure North 2644.6' to A-9 (Butterfield Survey (1978) = 2644.56')
Measure South 2645.0' to A-11 (Butterfield Survey (1978) = 2644.33')

Measure North 56.63' to M-10, T1N, R6E

Corner is 0.20' East of Twp. Line


C. Description of monument for corner and accessories established to perpetuate locating the position of the corner:

A-10 Replaced cap with brass cap stamped "Oakland County Remonumentation P.S. #25826."

- PK Nail & Oakland Co. Remonumentation Tag in W Side P. Pole S 35° E 43.65'
PK Nail & Oakland Co. Remonumentation Tag in E Side 10" Walnut S 20° W 60.94'
PK Nail & Oakland Co. Remonumentation Tag in E Side 10" Elm S 00° E 136.90'
PK Nail & Oakland Co. Remonumentation Tag in W Face Fence Post S 84° E 38.12'
1" Iron Pipe South 18.18'
Livingston Co. Mon. E 1/4 Sec. 25, T1N, R6E, North 56.63'

The selected location is accepted by the Contractor and is generally accepted by professional surveyors as the best available evidence of the position of the original corner.

Signed by Bruce Antcliff Date 12-10-98
EARTH TECH
Surveyor's Michigan License No. 25826

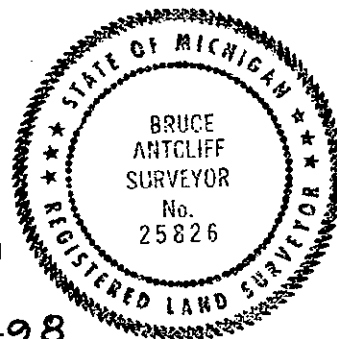

Grid table with columns A-L and rows 2-13, used for recording corner locations.

Handwritten note: 7.00 FILE 2.00