

MAR 1 1999

LIBER 19350PC879

JA-599001677

LAND CORNER RECORDATION CERTIFICATE
Filing Requirement of Act 74, Mich. P.A. 1970

\$ 7.00 MISCELLANEOUS RECORDING
\$ 2.00 REMONUMENTATION
5 JAN 99 8:25 A.M. RECEIPT# BA
PAID RECORDED - OAKLAND COUNTY
G. WILLIAM CARROLL
CLERK/REGISTER OF DEEDS

SECTION


For corners in

Table with columns: Oakland (County), Located in: Lyon Township, Corner Code #. Rows include Public Land Survey, Property Controlling in Section, and Miscellaneous Property in Sec.

Compliance with ACT 345, P.A. 1990
APPROVED ON: 12-21-98 JS
OAKLAND COUNTY REMONUMENTATION PEER GROUP COMMITTEE
Register of Deeds Stamp & File Number

- 4. Lot No.
5. Private Claims

I, Randy Kolehouse, in a field survey on December 21 19 98, do hereby certify that under requirements of P.A. 74 Michigan P.A. of 1970, the corner points mentioned in lines 1 and 2 above were in conformance with regulations and rules therefore as required in the current manual of survey instructions of the United States Department of the interior, Bureau of Land Management or by a decree of a Court of Law and/or that the corner points mentioned in lines 3, 4 and 5 above were in conformance with the rules of the Michigan Board of Land Surveyors or by a Decree of a Court of Law; established, re-established, monumented, re-monumented, recovered, found as expressed below:

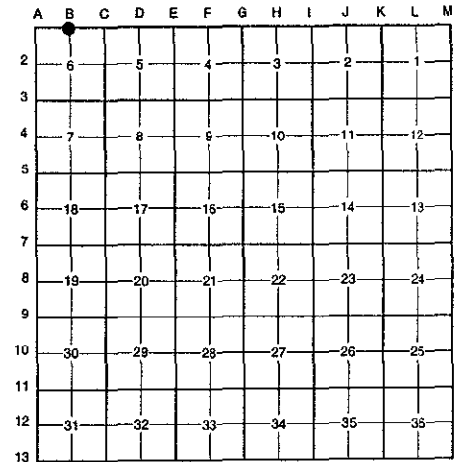

NOTE: Not more than 4 corners, all in the same town and range, may be recorded on this certificate.

- A. Description of original monument and accessories and/or subsequent restoration:
B-1 This corner was not originally set by the G.L.O.
N/A N/A O.C. Tax Maps N/A

Records indicate this corner is not common with B-13, T2N, R7E

- B. Description of corner evidence found and/or method applied in restoring or reestablishing corner:
B-1. This corner was not originally set by the G.L.O. Alex Holmes (G.L.O.) ran East from the Township corner 38 chains and set a point on the West bank of a lake with the Huron River flowing out. (The 1/4 corner for Section 31, T2N, R7E would have been approximately 24 chains West of the Township corner.) Set a theoretical point for B-1 on the Township line 2640.0' (40 chains) West of C-1, T1N, R7E. This point falls in a golf course 280' +/- West of the West edge of Kent Lake.

Calculate 2640.0' B-1 to C-1
Measure West 1540.9' to A-1

- C. Description of monument for corner and accessories established to perpetuate locating the position of the corner:
B-1 Set a capped rebar with a 5/8" x 24" rebar with brass cap stamped "Oakland County Remonumentation P.S. #25854."
PK Nail & Oakland Co. Remonumentation Tag in W Side 20" Oak N 15° E 21.61'
PK Nail & Oakland Co. Remonumentation Tag in N Side 18" Oak N 80° E 49.24'
PK Nail & Oakland Co. Remonumentation Tag in W Side 10" Cherry S 05° E 36.98'
PK Nail & Oakland Co. Remonumentation Tag in S Side 12" Cherry S 80° W 86.62'
No Occupation N-S-E-W

7.00 FILE
2.00

The selected location is accepted by the Contractor and is generally accepted by professional surveyors as the best available evidence of the position of the original corner.

Signed by Randy J. Kolehouse Date 12/28/98
EARTH TECH
Surveyor's Michigan License No. 25854

