

MAR 16 1999

LIBER 1935070884

SECTION

LAND CORNER RECORDATION CERTIFICATE
Filing Requirement of Act 74, Mich. P.A. 1970

\$ 9.00 MISCELLANEOUS RECORDING
\$ 2.00 REMONUMENTATION

5 JAN 99 8:26 A.M. RECEIPT PAID
RECORDED - OAKLAND COUNTY
G.WILLIAM CADDELL
CLERK/REGISTER OF DEEDS


For corners in

Section	Located in:	Township	Corner Code #
1. Public Land Survey	T <u>1N</u> R <u>7E</u>		<u>C-3</u>
	T _____ R _____		_____
	T _____ R _____		_____
	T _____ R _____		_____
2. Property Controlling in Section	S _____ T _____ R _____		_____
	S _____ T _____ R _____		_____
3. Miscellaneous Property in Sec.	S _____ T _____ R _____		_____
	S _____ T _____ R _____		_____

Compliance with ACT 345, P.A. 1990
APPROVED ON: 12-16-98 53
OAKLAND COUNTY REMONUMENTATION PEER GROUP COMMITTEE

Register of Deeds Stamp & File Number

- 4. Lot No. _____, Recorded Plat _____
- 5. Private Claims _____

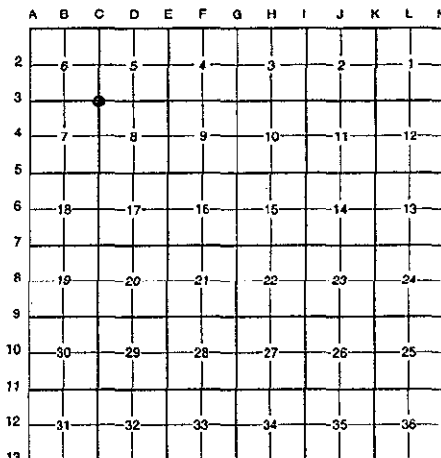

I, Bruce Antcliff, in a field survey on July 23, 1998 19 98, do hereby certify that under requirements of P.A. 74 Michigan P.A. of 1970, the corner points mentioned in lines 1 and 2 above were in conformance with regulations and rules therefore as required in the current manual of survey instructions of the United States Department of the interior, Bureau of Land Management or by a decree of a Court of Law and/or that the corner points mentioned in lines 3, 4 and 5 above were in conformance with the rules of the Michigan Board of Land Surveyors or by a Decree of a Court of Law; established, re-established, monumented, re-monumented, recovered, found as expressed below:

NOTE: Not more than 4 corners, all in the same town and range, may be recorded on this certificate.

A. Description of original monument and accessories and/or subsequent restoration:

C-3	1816	Holmes	G.L.O.	Set Post
	1984	Feldhauser	Cobblestone Vil. L. 183 P. 27	N/A
	1985	Soderquist	Cobblestone Vil. Sub. No. 2 L. 185 P. 22	N/A

(Continued on Back)

B. Description of corner evidence found and/or method applied in restoring or reestablishing corner:

C-3 Found a 3/4" iron rod on the C/L of Silver Lake Road (bit.) running West, the C/L of Pontiac Trail Road (bit.) running East, and the C/L of the northbound traffic lane of Pontiac Trail Road (bit.) running South. Found 3/4" iron checks Boss Survey (1993), and Orchard Edge Estates and Martindale Meadows Sub. #2.

Boss Survey
S 5° W (S 73° W) PK in Pole 103.67' (m. 103.48')

- Measure North 2664.1' to C-2 (G.L.O. = 2640.0') (Cobblestone Village No. 3, No. 4, and No. 5 = 2662.91')
- Measure South 2637.1' to C-4 (G.L.O. = 2640.0') (Orchard Edge Estates = 2637.01')
- Measure East 2650.1' to D-3 (G.L.O. = 2645.94') (Boss Survey (1993) = 2650.0') (Martindale Meadows Sub. #2 = 2651.30') (Martindale Meadows Sub. #3 = 2651.30')
- Measure West 2636.8' to B-3 (G.L.O. = 2640.0') (O.C. Tax Map = 2636.61')

C. Description of monument for corner and accessories established to perpetuate locating the position of the corner:

C-3 Replaced 3/4" iron rod with a 5/8" x 24" rebar with brass cap stamped "Oakland County Remonumentation P.S. #25826." Also set a new monument box.


- PK Nail & Oakland Co. Remonumentation Tag in NE Side Guy Pole S 17° E 76.17'
- PK Nail & Oakland Co. Remonumentation Tag in NW'y Side P. Pole S 73° W 103.48'
- PK Nail & Oakland Co. Remonumentation Tag in NE Side Light Pole N 45° W 59.75'
- PK Nail & Oakland Co. Remonumentation Tag in NE Side 6" Basswood N 50° E 59.42'

The selected location is accepted by the Contractor and is generally accepted by professional surveyors as the best available evidence of the position of the original corner.

Signed by Bruce Antcliff
EARTH TECH

Date 12-22-98

Surveyor's Michigan License No. 25826

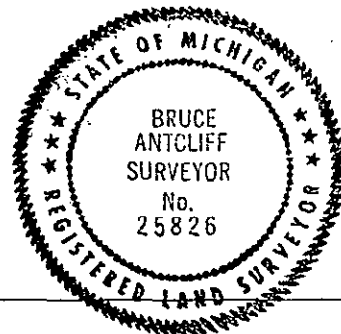

900 FILE
200

CURRENTS - M.
RECONVECTION

MAR 11 1999

Liber 19350 Pg 884.1

SECTION

A. Description of original monument and accessories and/or subsequent restoration:

C-3	1986	Gilmore	Cobblestone Vil. Sub. No. 3 L. 188 P. 16	N/A
	1987	DeKeyser	Orchard Edge Est. L. 192 P. 19	N/A
	1988	Soderquist	Cobblestone Vil. Sub. No. 4 L. 199 P. 36	N/A
	1988	DeKeyser	Martindale Meadows No. 2 L. 201 P. 19	N/A
	198_	DeKeyser	Martindale Meadows No. 3 L. 205 P. 37	N/A
	1990	Soderquist	Cobblestone Vil. Sub. No. 5 L. 212 P. 36	N/A
	199_	G. Boss	Survey	1" Iron Rod
	N/A	N/A	O.C. Tax Maps	N/A