

MAR 11 1999

LIBER 1929676548

LAND CORNER RECORDATION CERTIFICATE
Filing Requirement of Act 74, Mich. P.A. 1970

For corners in SECTION
Oakland (County)

Located in: Lyon Township Corner Code #


- 1. Public Land Survey T 1N R 7E C-8
2. Property Controlling in Section S T R
3. Miscellaneous Property in Sec. S T R

- 4. Lot No. Recorded Plat
5. Private Claims

\$ 9.00 MISCELLANEOUS RECORDING
\$ 2.00 REMONUMENTATION
17 DEC 98 3:32 P.M. RECEIPT# 518
PAID RECORDED - OAKLAND COUNTY
G. WILLIAM CABBELL
CLERK/REGISTER ACT 345, P.A. 1990

APPROVED ON: 11-10-98 JS
OAKLAND COUNTY REMONUMENTATION
PEER GROUP COMMITTEE

Register of Deeds Stamp & File Number

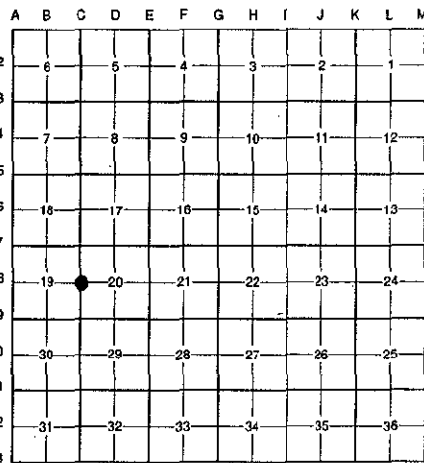

I, Bruce Antcliff, in a field survey on July 29 19 98, do hereby certify that under requirements of P.A. 74 Michigan P.A. of 1970, the corner points mentioned in lines 1 and 2 above were in conformance with regulations and rules therefore as required in the current manual of survey instructions of the United States Department of the interior, Bureau of Land Management or by a decree of a Court of Law and/or that the corner points mentioned in lines 3, 4 and 5 above were in conformance with the rules of the Michigan Board of Land Surveyors or by a Decree of a Court of Law; established, re-established, monumented, re-monumented, recovered, found as expressed below:

NOTE: Not more than 4 corners, all in the same town and range, may be recorded on this certificate.

A. Description of original monument and accessories and/or subsequent restoration:

C-8 1816 Holmes G.L.O. Set Post
1980 Munzel L.C.R.C. L. 7900 P. 300 R.R. Spike
1988 Kapelczak Cert. Survey L. 10747 P. 816 Set Iron

(Continued on Back)

B. Description of corner evidence found and/or method applied in restoring or reestablishing corner:

C-8 Found a capped iron in a monument box on the C/L of Pontiac Trail Road (bit.) running North and South and 50' +/- North of the C/L of Maple Drive (bit.) running East. The capped iron in monument box checks surveys from 1980 to the present. Also checks the following witnesses:

L.C.R.C. L. 7900 P. 300 Cert. Survey L. 10747 P. 816 (1988)
W'y 28.2 to Nail S Side U.P. (m. 28.23') N 33° W 52.27' PK w/Washer E Side Guard Rail Post (m. 52.24')
S 90° W 28.22' PK w/Washer N Side L.P. (m. 28.23')

Measure North 2632.52' to C-7 (G.L.O. = 2640.0')(Kapelczak Survey (1988) = 2633.04')(Boss Survey (1991) = 2632.38')
(Southridge Condo. = 2632.57')
Measure South 2633.74' to C-9 (G.L.O. = 2640.0')(Boss Survey (1989) = 2633.80')

C. Description of monument for corner and accessories established to perpetuate locating the position of the corner:


C-8 Replaced capped iron in a monument box with a 5/8" x 24" rebar with brass cap stamped "Oakland County Remonumentation P.S. #25826" in an existing monument box.

PK Nail & Oakland Co. Remonumentation Tag in E Side of 6" x 6" Guard Rail Post N 33° W 52.24'
PK Nail & Oakland Co. Remonumentation Tag in N Side P. Pole S 90° W 28.23'
PK Nail & Oakland Co. Remonumentation Tag in Top of Guard Rail Post S 42° W 25.22'
Chisled "X" on W. Side Dome Covered C.B. S 81° E 38.26'

The selected location is accepted by the Contractor and is generally accepted by professional surveyors as the best available evidence of the position of the original corner.

Signed by Bruce Antcliff Date 12-10-98
EARTH TECH

Surveyor's Michigan License No. 25826

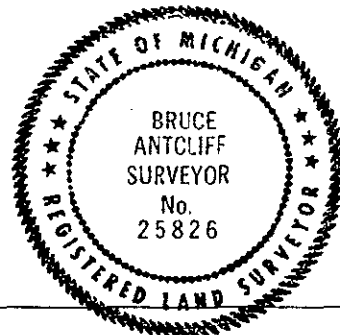

MAR 11 1989

LIBER 19296 PG 549

SECTION

A. Description of original monument and accessories and/or subsequent restoration:

C-8	1989	G. Boss	Cert. Survey L. 11156 P. 256	N/A
	1989	G. Boss	Cert. Survey L. 11156 P. 257	Iron Pipe in Mon. Box
	1989	G. Boss	Survey	N/A
	1989	G. Boss	Survey	Iron in Mon. Box
	1990	G. Boss	Cert. Survey L. 11153 P. 048	N/A
	1991	G. Boss	Cert. Survey L. 11848 P. 640	N/A
	N/A	N/A	O.C. Tax Maps	N/A