

DEC 11 1998

LIBER 19296PG550

LAND CORNER RECORDATION CERTIFICATE
Filing Requirement of Act 74, Mich. P.A. 1970

SECTION

For corners in

Form with fields for County (Oakland), Township (Lyon), Corner Code # (C-9), and numbered sections 1-5 for Public Land Survey, Property Controlling, Miscellaneous Property, Lot No., and Private Claims.

Stamp area containing recording fees (\$9.00, \$2.00), date (17 DEC 98 3:32 P.M.), recorder name (G. WILLIAM CADDELL), and approval signature (12-01-98 J).

I, Bruce Antcliff, in a field survey on July 29, 1998, do hereby certify that under requirements of P.A. 74 Michigan P.A. of 1970, the corner points mentioned in lines 1 and 2 above were in conformance with regulations and rules therefore as required in the current manual of survey instructions of the United States Department of the interior, Bureau of Land Management or by a decree of a Court of Law and/or that the corner points mentioned in lines 3, 4 and 5 above were in conformance with the rules of the Michigan Board of Land Surveyors or by a Decree of a Court of Law; established, re-established, monumented, re-monumented, recovered, found as expressed below:

NOTE: Not more than 4 corners, all in the same town and range, may be recorded on this certificate.

A. Description of original monument and accessories and/or subsequent restoration:

Table with 4 columns: Corner Code, Name, Description, and Material. Includes entries for C-9 1816 Holmes G.L.O. Set Post, 1927 Baldwin Survey Iron Pipes, 1932 Wrenn Accessor's Plat #2 L. 52 P. 39 N/A, 1947 Johnson Accessor's Plat #5 L. 58 P. 30 N/A, and N/A Baldwin Witnesses N/A.

(Continued on Back)

B. Description of corner evidence found and/or method applied in restoring or reestablishing corner:

C-9 Found a 3/4" iron in a square monument box on the C/L intersection of Pontiac Trail (bit.) running North and South and 10 Mile Road (bit.) running East and West. The found iron checks surveys and L.C.R.C.'s from 1975 to the present. Also checks the following witnesses:

Table with 2 columns: Witness Name and Location/Measurement. Includes Lyon Township Witnesses (47.55' Bank Bldg., 49.65' Building) and L.C.R.C. L. 7582 P. 279 (1979) (47.50' Building Corner N.E., 51.05' Building Corner N.W., 49.45' Building Corner S.E.).

- Measure North 2633.74' to C-8 (G.L.O. = 2640.0') (Boss Survey (1989) = 2633.80')
Measure South 2632.31' to C-10 (G.L.O. = 2640.0')
Measure East 2666.09' to D-9 (G.L.O. = 2659.8') (Boss Survey (1991) = 2666.16')
Measure West 2638.8' to B-9 (G.L.O. = 2640.0')


C. Description of monument for corner and accessories established to perpetuate locating the position of the corner:

C-9 Replaced 3/4" iron in a square monument box with a 5/8" x 24" rebar with brass cap stamped "Oakland County Remonumentation P.S. #25826" in an existing monument box.


- SW Cor. Building N 45° E 47.55'
NW Cor. Building S 45° E 49.27'
SE Cor. Building N 45° W 50.96'
NE Cor. Building S 45° W 70.35'

The selected location is accepted by the Contractor and is generally accepted by professional surveyors as the best available evidence of the position of the original corner.

Signed by Bruce Antcliff, Date 12-10-98, EARTH TECH, Surveyor's Michigan License No. 25826

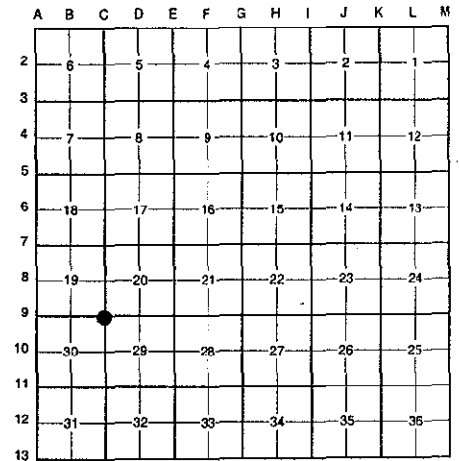

Handwritten note: 9.00 FILE 2.00

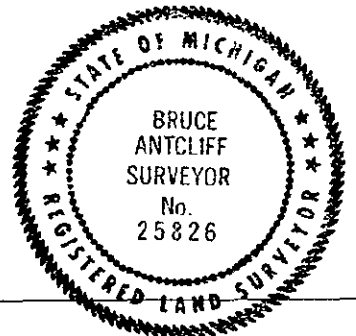

1998 11 1999

SECTION

NUMBER 192960551

A. Description of original monument and accessories and/or subsequent restoration:

C-9	N/A	N/A	Sec. Cor. Ties	N/A
	1975	Postiff	L.C.R.C. L. 6554 P. 688	3/4" Iron
	1978	Finney	Cert. Survey L. 7659 P. 256	3/4" Iron in Mon. Box
	1979	Butterfield	L.C.R.C. L. 7582 P. 279	3/4" Iron in Mon. Box
	1979	Finney	L.C.R.C. L. 7580 P. 810	3/4" Iron in Mon. Box
	1991	G. Boss	Cert. Survey L. 11998 P. 643	N/A
	N/A	N/A	O.C. Tax Maps	N/A