

1993

LIBER 19296PC563

SECTION

LAND CORNER RECORDATION CERTIFICATE
Filing Requirement of Act 74, Mich. P.A. 1970

For corners in Oakland (County) Located in: Lyon Township Corner Code # _____

1. Public Land Survey T 1N R 7E Corner Code # D-7

2. Property Controlling in Section S _____ T _____ R _____

3. Miscellaneous Property in Sec. S _____ T _____ R _____

4. Lot No. _____, Recorded Plat _____


5. Private Claims _____

\$ 9.00 MISCELLANEOUS RECORDING
\$ 2.00 REMONUMENTATION
17 DEC 98 3:34 P.M. RECEIPT# JLR
PAID RECORDED - OAKLAND COUNTY
G. WILLIAM CADDELL
CLERK/REGISTER OF DEEDS

Compliance with ACT 345, P.A. 1990
APPROVED ON: 11-10-98 JS
OAKLAND COUNTY REMONUMENTATION PEER GROUP COMMITTEE

Register of Deeds Stamp & File Number

I, Bruce Antcliff, in a field survey on June 16 19 98, do hereby certify that under requirements of P.A. 74 Michigan P.A. of 1970, the corner points mentioned in lines 1 and 2 above were in conformance with regulations and rules therefore as required in the current manual of survey instructions of the United States Department of the interior, Bureau of Land Management or by a decree of a Court of Law and/or that the corner points mentioned in lines 3, 4 and 5 above were in conformance with the rules of the Michigan Board of Land Surveyors or by a Decree of a Court of Law; established, re-established, monumented, re-monumented, recovered, found as expressed below:

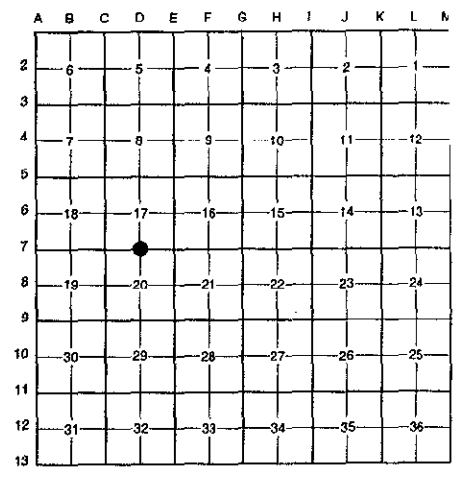

NOTE: Not more than 4 corners, all in the same town and range, may be recorded on this certificate.

A. Description of original monument and accessories and/or subsequent restoration:

D-7 1816 Holmes G.L.O. Set Post
1967 N/A O.C.R.C. Sec. Cor. Ties Stone

(Continued on Back)

B. Description of corner evidence found and/or method applied in restoring or reestablishing corner:

D-7 Found a 1/2" rebar in a monument box .5' North of the C/L of 11 Mile Road (bit.) running East and West on line of a tree row running North. The found iron in a monument box checks surveys and L.C.R.C.'s from 1963 to the present. Also checks the following witnesses:

O.C.R.C. Sec. Corner Ties (1967)	Unrecorded Survey (1988)	Cert. Survey L. 16936 P. 210 (1997)
76.00' 12" Hickory	North 23.54' to Nail in SE Face U.P. (m. 23.54')	South 56.81' N/T W/S P. Pole (m. 56.76')
	N 65° W 78.15' to PK in 20" Elm (m. 78.14')	N 77° W 126.65' N/T N/S P. Pole (m. 126.65')
	South 56.89' to Nail w/Cap #29238 U.P. (m. 56.76')	N 04° W 23.52' Nail E/S P. Pole (m. 23.54')

Measure East 2647.72' to E-7 (G.L.O. = 2641.65') (Boss Survey (1991) = 2647.67') (Boss Survey (1993) = 2647.68')

Measure West 2647.44' to C-7 (G.L.O. = 2641.65') (Boss Survey (1991) = 2647.54') (Boss Survey (1993) = 2647.54')

500 FILE
200 FILE


C. Description of monument for corner and accessories established to perpetuate locating the position of the corner:

D-7 Replaced 1/2" rebar in a monument box with a 5/8" x 24" rebar with brass cap stamped "Oakland County Remonumentation P.S. #25826" in an existing monument box.

PK Nail & Oakland Co. Remonumentation Tag in E Side P. Pole North 23.54'
PK Nail & Oakland Co. Remonumentation Tag in NE Side 20" Elm N 65° W 78.14'
PK Nail & Oakland Co. Remonumentation Tag in W Side Util. Pole South 56.76'
PK Nail & Oakland Co. Remonumentation Tag in N Side P. Pole N 77° W 126.65'

The selected location is accepted by the Contractor and is generally accepted by professional surveyors as the best available evidence of the position of the original corner.

Signed by Bruce Antcliff Date 12-10-98
EARTH TECH

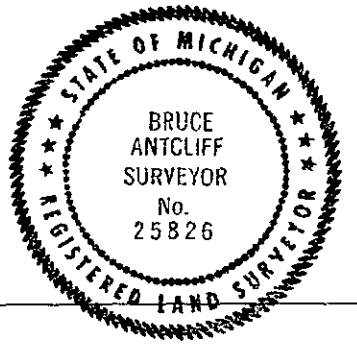

Surveyor's Michigan License No. 25826

SECTION

1899

LIBER 19296 PC 564

SECTION

A. Description of original monument and accessories and/or subsequent restoration:

D-7	1973	Knapp	Survey	N/A
	1979	Roskelly	Cert. Survey L. 7673 P. 255	1" Iron Pipe
	1979	Kemnitz	Survey	N/A
	1988	Kostecke	Survey	1/2" Rerod in Mon. Box
	1993	G. Boss	Survey Plan L. 13674 P. 407	N/A
	1996	G. Boss	Survey	1/2" Iron in Mon. Box
	1997	Boss	Cert. Survey L. 16936 P. 210	1/2" Iron in Mon. Box
	N/A	N/A	O.C. Tax Maps	N/A