

MAR 27 1999

LIBER 19296 PG 565

LAND CORNER RECORDATION CERTIFICATE
Filing Requirement of Act 74, Mich. P.A. 1970


For corners in SECTION

<u>Oakland</u> (County)	Located in: Lyon Township	Corner Code #
1. Public Land Survey	T <u>1N</u> R <u>7E</u>	<u>D-9</u>
	T _____ R _____	_____
	T _____ R _____	_____
	T _____ R _____	_____
2. Property Controlling in Section	S _____ T _____ R _____	_____
	S _____ T _____ R _____	_____
3. Miscellaneous Property in Sec.	S _____ T _____ R _____	_____
	S _____ T _____ R _____	_____
4. Lot No. _____, Recorded Plat _____		
5. Private Claims _____		

\$ 9.00 MISCELLANEOUS RECORDING
 \$ 2.00 REMONUMENTATION
 17 DEC 98 3:34 P.M. RECEIPT# 518
 PAID RECORDED - OAKLAND COUNTY
 G. WILLIAM CADDELL
 CLERK/REGISTER OF DEEDS
 Compliance with
 ACT 345, P.A. 1990
 APPROVED ON: 11-10-98 JS
 OAKLAND COUNTY REMONUMENTATION
 PEER GROUP COMMITTEE
 Register of Deeds Stamp & File Number

1198363693

I, Bruce Antcliff, in a field survey on June 17 19 98, do hereby certify that under requirements of P.A. 74 Michigan P.A. of 1970, the corner points mentioned in lines 1 and 2 above were in conformance with regulations and rules therefore as required in the current manual of survey instructions of the United States Department of the interior, Bureau of Land Management or by a decree of a Court of Law and/or that the corner points mentioned in lines 3, 4 and 5 above were in conformance with the rules of the Michigan Board of Land Surveyors or by a Decree of a Court of Law; established, re-established, monumented, re-monumented, recovered, found as expressed below:

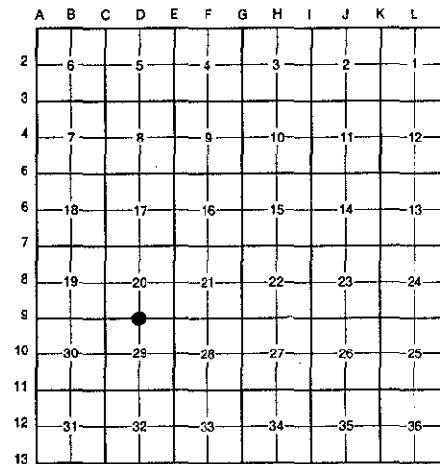

NOTE: Not more than 4 corners, all in the same town and range, may be recorded on this certificate.

A. Description of original monument and accessories and/or subsequent restoration:

D-9	1816	Holmes	G.L.O.	Set Post
	1971	Wilson	Cert. Survey L. 5770 P. 789	1" Iron Pipe
	1971	Wilson	L.C.R.C. L. 5754 P. 238	1" Iron Pipe

(Continued on Back)

B. Description of corner evidence found and/or method applied in restoring or reestablishing corner:

D-9 Found a PK nail 2.7' North of the C/L of Ten Mile Road (bit.) running East and West on line of a fence line running North. The found PK nail checks surveys and L.C.R.C.'s from 1971 to the present. Also checks the following witnesses:

L.C.R.C. L. 5754 P. 238 (1971)	L.C.R.C. L. 7731 P. 462 (1980)
N 10° W 25.4' P.P. (m. 25.61')	S 70° W 76.3' PK in N Face P.P. (m. 79.52')
S 10° W 41.7' 30" Maple (m. 41.57')	S 50° E 54.0' PK in N Face P.P. (m. 53.84')
S 35° E 58.0' 24" Maple (m. 57.80')	N 10° W 25.5' PK in E Face P.P. (m. 25.61')
	S 10° W 41.7' Nail in E Side 30" Maple (m. 41.57')

GW FILE
200

Measure East 2663.79' to E-9 (G.L.O. = 2659.8') (Wilson Surveys (1971) = 2663.55') (Boss Surveys (1989) = 2664.03')
 Measure West 2666.09' to C-9 (G.L.O. = 2659.8') (Boss Survey (1991) = 2666.16')

C. Description of monument for corner and accessories established to perpetuate locating the position of the corner:

D-9 Replaced PK nail with a 5/8" x 24" rebar with brass cap stamped "Oakland County Remonumentation P.S. #25826." Also set a new monument box.


PK Nail & Oakland Co. Remonumentation Tag in N Face P. Pole S 70° W 79.52'
 PK Nail & Oakland Co. Remonumentation Tag in N Face P. Pole S 50° E 53.84'
 PK Nail & Oakland Co. Remonumentation Tag in E Face P. Pole N 10° W 25.60'
 PK Nail & Oakland Co. Remonumentation Tag in E Side 30" Maple S 10° W 41.57'

The selected location is accepted by the Contractor and is generally accepted by professional surveyors as the best available evidence of the position of the original corner.

Signed by Bruce Antcliff Date 12-10-98

EARTH TECH

Surveyor's Michigan License No. 25826

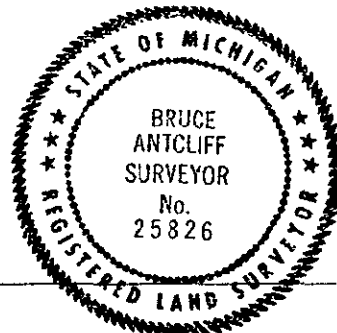

MAR 14 1999

SECTION

NUMBER 19296/0566

A. Description of original monument and accessories and/or subsequent restoration:

D-9	1974	O. Boss	Cert. Survey L. 6392 P. 875	1/2" Pipe
	1974	O. Boss	Cert. Survey L. 6420 P. 321	1/2" Pipe
	1974	O. Boss	Cert. Survey L. 6290 P. 96	1/2" Pipe
	1974	O. Boss	L.C.R.C. L. 6616 P. 817	1/2" Pipe
	1977	Carnahan	Cert. Survey L. 6879 P. 829	3/4" Pipe
	1978	Finney	Cert. Survey L. 7659 P. 256	3/4" Pipe
	1979	Finney	L.C.R.C. L. 7580 P. 810	3/4" Pipe
	1980	Butterfield	L.C.R.C. L. 7731 P. 462	1" Iron
	1989	G. Boss	Cert. Survey L. 11512 P. 289	N/A
	1989	G. Boss	Cert. Survey L. 11236 P. 342	N/A
	1990	G. Boss	Cert. Survey L. 11429 P. 009	N/A
	1991	G. Boss	Cert. Survey L. 11998 P. 643	N/A
	1991	G. Boss	Cert. Survey L. 12373 P. 027	N/A
	1996	N/A	Cert. Survey L. 6704 P. 616	N/A
	N/A	N/A	O.C. Tax Maps	N/A