

1999

LIBER 19296PC567

SECTION

LAND CORNER RECORDATION CERTIFICATE
Filing Requirement of Act 74, Mich. P.A. 1970

For corners in

<u>Oakland</u> (County)	Located in: Lyon Township	Corner Code #
1. Public Land Survey	T <u>1N</u> R <u>7E</u>	<u>D-11</u>
	T _____ R _____	_____
	T _____ R _____	_____
	T _____ R _____	_____
2. Property Controlling in Section	S _____ T _____ R _____	_____
	S _____ T _____ R _____	_____
3. Miscellaneous Property in Sec.	S _____ T _____ R _____	_____
	S _____ T _____ R _____	_____
4. Lot No. _____, Recorded Plat _____		
5. Private Claims _____		

\$ 9.00 MISCELLANEOUS RECORDING
 \$ 2.00 REMONUMENTATION
 17 DEC 98 3:34 P.M. RECEIPT# 518
 PAID RECORDED - OAKLAND COUNTY
 G. WILLIAM CADWELL
 CLERK/REGISTER OF DEEDS


Compliance with ACT 345, P.A. 1990

APPROVED ON: 12-10-98
 OAKLAND COUNTY REMONUMENTATION PEER GROUP COMMITTEE

Register of Deeds Stamp & File Number

DE 1798 3694

I, Bruce Antcliff, in a field survey on July 28 19 98, do hereby certify that under requirements of P.A. 74 Michigan P.A. of 1970, the corner points mentioned in lines 1 and 2 above were in conformance with regulations and rules therefore as required in the current manual of survey instructions of the United States Department of the interior, Bureau of Land Management or by a decree of a Court of Law and/or that the corner points mentioned in lines 3, 4 and 5 above were in conformance with the rules of the Michigan Board of Land Surveyors or by a Decree of a Court of Law; established, re-established, monumented, re-monumented, recovered, found as expressed below:

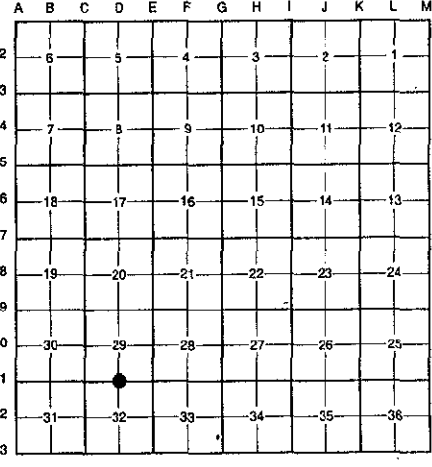

NOTE: Not more than 4 corners, all in the same town and range, may be recorded on this certificate.

A. Description of original monument and accessories and/or subsequent restoration:

D-11	1816	Holmes	G.L.O.	Set Post
	1963	N/A	O.C.R.C. Sec. Cor. Ties	1/2" Rod
	1975	Green	Cert. Survey L. 6502 P. 230	N/A

(Continued on Back)

B. Description of corner evidence found and/or method applied in restoring or reestablishing corner:

D-11 Found 1/2" iron on the C/L of 9 Mile Road (gravel) running East and West on line of a tree row running South and 33.0' North of an iron on the South right-of-way line of 9 Mile Road. The found 1/2" iron checks surveys and L.C.R.C.'s from 1963 to the present. Also checks the following witnesses:

O.C.R.C. Sec. Corner Ties (1963)	Cert. Survey 6502 P. 230 (1975)	L.C.R.C. L. 6982 p. 537 (1977)
ESE 45.89' Nail NE Side 24" Hickory (m. 45.34')	S 33' to Iron Stake	ESE 45.63' Nail NE/S 24" Hickory (m. 45.34')
WSW 54.04' Nail NW Side 30" Hickory (m. 53.93')	S 60° E 45.75' to 24" Hickory (m. 45.34')	WSW 53.51' Nail SE/S 30" Hickory (m. 53.93')
	S 70° W 54.1' to 30" Hickory (m. 53.93')	

Measure East 2644.8' to E-11 (G.L.O. = 2656.5')
 Measure West 2646.51' to C-11 (G.L.O. = 2656.5') (Boss Survey (1977 & 1982) = 2646.51')

C. Description of monument for corner and accessories established to perpetuate locating the position of the corner:

D-11 Replaced 1/2" iron with a 5/8" x 24" rebar with brass cap stamped "Oakland County Remonumentation P.S. #25826."


PK Nail & Oakland Co. Remonumentation Tag in NE Side 14" Hickory S 52° E 45.34'
 PK Nail & Oakland Co. Remonumentation Tag in NW Side 26" Hickory S 72° W 53.93'
 PK Nail & Oakland Co. Remonumentation Tag in SW Side 24" Maple N 63° W 68.98'
 PK Nail & Oakland Co. Remonumentation Tag in SW Side 12" Hickory N 46° W 53.47'
 South 33.03' to Iron Stake

The selected location is accepted by the Contractor and is generally accepted by professional surveyors as the best available evidence of the position of the original corner.

Signed by Bruce Antcliff Date 12-10-98

EARTH TECH

Surveyor's Michigan License No. 25826

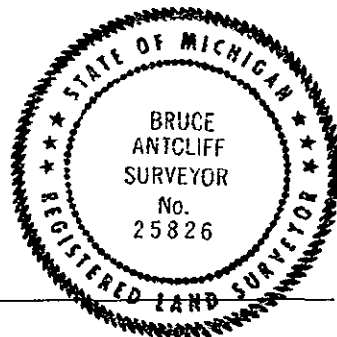

MAR 11 1989

SECTION

LIBER 19296 P. 568

A. Description of original monument and accessories and/or subsequent restoration:

D-11	1977	Kostecke	Cert. Survey L. 7085 P. 796	N/A
	1977	G. Boss	L.C.R.C. L. 6982 P. 537	1/2" Iron
	1977	G. Boss	Cert. Survey L. 6982 P. 515	1/2" Iron
	1982	G. Boss	Cert. Survey L. 8313 P. 570	N/A
	1986	Ward	L.C.R.C. L. 9714 P. 782	Unknown
	1995	G. Boss	Cert. Survey L. 16936 P. 220	N/A
	N/A	N/A	O.C. Tax Maps	N/A