

SECTION

LIBER 19296PG569

LAND CORNER RECORDATION CERTIFICATE
Filing Requirement of Act 74, Mich. P.A. 1970

For corners in

Table with columns: Oakland (County), Located in: Lyon Township, Corner Code #. Rows include Public Land Survey, Property Controlling in Section, Miscellaneous Property in Sec., Lot No., and Private Claims.

\$ 7.00 MISCELLANEOUS RECORDING
\$ 2.00 REMONUMENTATION
17 DEC 98 3:34 P.M. RECEIPT# 518
PAID RECORDED - OAKLAND COUNTY
G. WILLIAM CADDELL
CLERK/REGISTER OF DEEDS

Compliance with ACT 345, P.A. 1990
APPROVED ON: 11-10-98 JS
OAKLAND COUNTY REMONUMENTATION PEER GROUP COMMITTEE
Register of Deeds Stamp & File Number

DE 17 98 36 26 95

I, Bruce Antcliff, in a field survey on October 22 19 98, do hereby certify that under requirements of P.A. 74 Michigan P.A. of 1970, the corner points mentioned in lines 1 and 2 above were in conformance with regulations and rules therefore as required in the current manual of survey instructions of the United States Department of the interior, Bureau of Land Management or by a decree of a Court of Law and/or that the corner points mentioned in lines 3, 4 and 5 above were in conformance with the rules of the Michigan Board of Land Surveyors or by a Decree of a Court of Law; established, re-established, monumented, re-monumented, recovered, found as expressed below:

NOTE: Not more than 4 corners, all in the same town and range, may be recorded on this certificate.

A. Description of original monument and accessories and/or subsequent restoration:

Table with columns: D-13, 1816, 1973, 1995, 1995, N/A; Holmes, Roskelly, G. Boss, G. Boss, N/A; G.L.O., Cert. Survey L. 6259 P. 862, Cert. Survey L. 16936 P. 217, Cert. Survey L. 16936 P. 220, O.C. Tax Maps; Set Post, N/A, N/A, N/A, N/A.

Records indicate this corner is not common with D-1, T1S, R7E

B. Description of corner evidence found and/or method applied in restoring or reestablishing corner:

D-13 Found nothing at this corner. Reset corner using 33' South of found Boss irons along the N/L of 8 Mile Road and record dist. from C-13 to D-13 and D-13 to E-13. Checks 1/2 mile Boss meas. +/- 0.10'. This point falls on the C/L of 8 Mile Road (bit.) running East and West on line of a tree row running North. This point is 315.5' West of D-1, T1S, R7E.

Measure East 2635.33' to E-13 (G.L.O. = 2640.0') (Boss Survey (1995) = 2635.25')
Measure West 2635.60' to C-13 (G.L.O. = 2640.0') (Boss Survey (1995) = 2635.48')
Measure East 315.5' to D-1, T1S, R7E.


C. Description of monument for corner and accessories established to perpetuate locating the position of the corner:

D-13 Replaced PK nail with a 5/8" x 24" rebar with brass cap stamped "Oakland County Remonumentation P.S. #25826." Also set a new monument box.

- PK Nail & Oakland Co. Remonumentation Tag in NE Face P. Pole S 80° E 97.10'
PK Nail & Oakland Co. Remonumentation Tag in SE Face P. Pole S 53° W 58.85'
PK Nail & Oakland Co. Remonumentation Tag in N Side 8" Oak N 64° W 66.92'
PK Nail & Oakland Co. Remonumentation Tag in SE Side 32" Oak N 64° E 62.24'

The selected location is accepted by the Contractor and is generally accepted by professional surveyors as the best available evidence of the position of the original corner.

Signed by Bruce Antcliff Date 12-10-98
EARTH TECH
Surveyor's Michigan License No. 25826

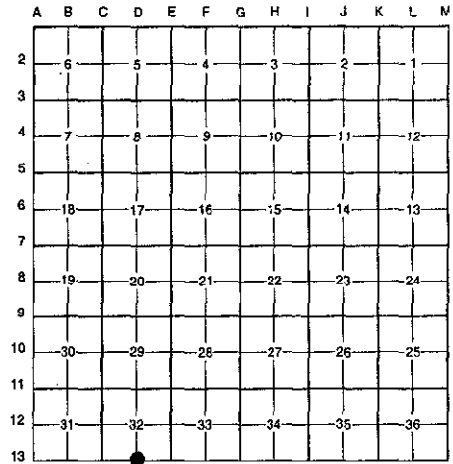

700 FILE
200

