

SECTION

LAND CORNER RECORDATION CERTIFICATE
Filing Requirement of Act 74, Mich. P.A. 1970

For corners in

Oakland (County)	Located in: Lyon Township	Corner Code #
1. Public Land Survey	T <u>1N</u> R <u>7E</u>	<u>E-1</u>
	T _____ R _____	_____
	T _____ R _____	_____
	T _____ R _____	_____
2. Property Controlling in Section	S _____ T _____ R _____	_____
	S _____ T _____ R _____	_____
3. Miscellaneous Property in Sec.	S _____ T _____ R _____	_____
	S _____ T _____ R _____	_____

\$ 7.00 MISCELLANEOUS RECORDING
\$ 2.00 REMONUMENTATION
3 JAN 99 8:27 A.M. RECEIPT# 8A
PAID RECORDED - OAKLAND COUNTY
G. WILLIAM CADRELL
CLERK/REGISTER OF DEEDS
Compliance with
ACT 345, P.A. 1990
 APPROVED ON: 12-21-98 JS
OAKLAND COUNTY REMONUMENTATION
PEER GROUP COMMITTEE
Register of Deeds Stamp & File Number

- 4. Lot No. _____, Recorded Plat _____
- 5. Private Claims _____

I, Randy Kolehouse, in a field survey on October 23 19 98, do hereby certify that under requirements of P.A. 74 Michigan P.A. of 1970, the corner points mentioned in lines 1 and 2 above were in conformance with regulations and rules therefore as required in the current manual of survey instructions of the United States Department of the Interior, Bureau of Land Management or by a decree of a Court of Law and/or that the corner points mentioned in lines 3, 4 and 5 above were in conformance with the rules of the Michigan Board of Land Surveyors or by a Decree of a Court of Law; established, re-established, monumented, re-monumented, recovered, found as expressed below:

NOTE: Not more than 4 corners, all in the same town and range, may be recorded on this certificate.

A. Description of original monument and accessories and/or subsequent restoration:

E-1	Description	Accessories	Restoration
1816	Holmes	G.L.O.	Set Post
1966	N/A	MDOT Highway Plan	1" Iron
1986	DeKeyser	Bramley Hills Sub. L. 187 P. 29	N/A
1987	Gorman	L.C.R.C. L. 10156 P. 502	1/2" Rerod
1992	Milletics	L.C.R.C. L. 12432 P. 199	1/2" Rerod
N/A	N/A	O.C. Tax Maps	N/A

Records indicate this corner is not common with E-13, T2N, R7E

B. Description of corner evidence found and/or method applied in restoring or reestablishing corner:

E-1 Found rerod 86.44' West of Oakland County Monument at E-13, T2N, R7E, in North right-of-way fence to I-96 running Northwest to Southeast, on line of a tree row running South. The found rerod is 6.0' South of the Township line. The measurement South to E-2 from the Town line checks MDOT +0.78' The found rerod checks surveys and L.C.R.C.'s from 1987 to the present. Also checks the following witnesses:

L.C.R.C. L. 10156 P. 502 (1987)	L.C.R.C. L. 12432 P. 199 (1992)
S 10° W 7.23' PK Nail E Face 16" Oak (m. 7.12')	South 7.23' PK E Side 18" Oak (m. 7.12')
N 65° E 21.55' PK Nail S Face 10" Oak (m. 21.50')	East 16.09' PK S Side 12" Oak (m. 16.14')
	Northeast 15.49' PK NE Side 11" Oak (m. 15.48')
	Northwest 33.88' PK W Side 13" Oak (m. 33.87')

Measure South 3313.53' to E-2 (G.L.O. = 3306.60') (Bramley Hills Sub. = 3287.49') (MDOT = 3312.35')
 Measure East 2567.63' to F-1 (MDOT calc. distance = 2567.63')
 Measure West 2680.0' to D-1

Measure East 86.44' to E-13, T2N, R7E


C. Description of monument for corner and accessories established to perpetuate locating the position of the corner:

E-1 Reset point 6.0' North of found iron (on Township line). This point falls on the North side of a 2' diameter stone. Set a visible "X" on stone.

- PK Nail & Oakland Co. Remonumentation Tag in S Side 18" Oak S 02° E 13.11'
- PK Nail & Oakland Co. Remonumentation Tag in S Side 12" Oak N 90° E 17.85'
- PK Nail & Oakland Co. Remonumentation Tag in NE Side 11" Oak N 05° E 10.40'
- PK Nail & Oakland Co. Remonumentation Tag in SW Side 12" Oak N 50° W 29.84'
- Brass Cap Monument E-13, T2N, R7E, N 90° E 86.44'
- Rerod South 6.0'

The selected location is accepted by the Contractor and is generally accepted by professional surveyors as the best available evidence of the position of the original corner.

Signed by Randy Kolehouse Date 12/29/98
 Surveyor's Michigan License No. 25854

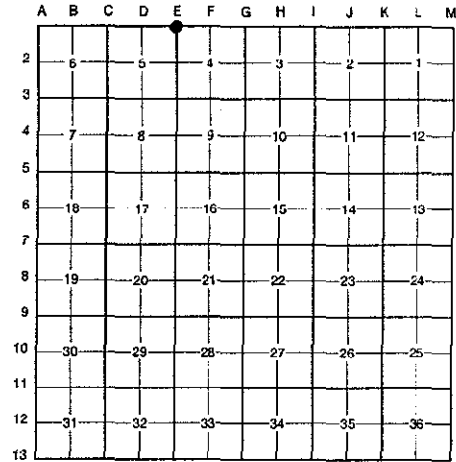

700 FILE
200