

MAR 14 1999

LIBER 19350P0887

SECTION

LAND CORNER RECORDATION CERTIFICATE
Filing Requirement of Act 74, Mich. P.A. 1970

\$ 9.00 MISCELLANEOUS RECORDING
\$ 2.00 REMONUMENTATION
5 JAN 99 8:27 A.M. RECEIPT# 8A
PAID RECORDED - OAKLAND COUNTY
G. WILLIAM CADWELL
CLERK/REGISTER OF DEEDS
Compliance with
ACT 345, P.A. 1990
APPROVED ON: 12-21-98 JS
OAKLAND COUNTY REMONUMENTATION
PEER GROUP COMMITTEE
Register of Deeds Stamp & File Number

For corners in

Oakland (County)	Located in: Lyon Township	Corner Code #
1. Public Land Survey	T 1N R 7E	E-2
	T R	
	T R	
	T R	
2. Property Controlling in Section	S T R	
	S T R	
3. Miscellaneous Property in Sec.	S T R	
	S T R	

- 4. Lot No. _____, Recorded Plat _____
- 5. Private Claims _____

I, Bruce Antcliff, in a field survey on August 5 19 98, do hereby certify that under requirements of P.A. 74 Michigan P.A. of 1970, the corner points mentioned in lines 1 and 2 above were in conformance with regulations and rules therefore as required in the current manual of survey instructions of the United States Department of the interior, Bureau of Land Management or by a decree of a Court of Law and/or that the corner points mentioned in lines 3, 4 and 5 above were in conformance with the rules of the Michigan Board of Land Surveyors or by a Decree of a Court of Law; established, re-established, monumented, re-monumented, recovered, found as expressed below:

NOTE: Not more than 4 corners, all in the same town and range, may be recorded on this certificate.

A. Description of original monument and accessories and/or subsequent restoration:

E-2	1816	Holmes	G.L.O.	Set Post
	1966	N/A	MDOT Highway Plans	N/A
	1976	Smith	L.C.R.C. L. 6961 P. 102	N/A
	1976	Smith	Cert. Survey L. 6759 P. 668	Iron

(Continued on Back)

B. Description of corner evidence found and/or method applied in restoring or reestablishing corner:

E-2 Found a 1/2" rebar on the North right-of-way line of Montego Road (gravel - 60' wide) running East and West on line of a tree row running North. The found 1/2" rebar checks surveys and L.C.R.C.'s from 1987 to the present. Also checks the following witnesses:

- L.C.R.C. L. 6961 P. 102 (1976) NW'ly 17.76' to 30" Oak (m. 17.42') SE'ly 8.55' to 14" Hickory (m. 8.58')
- L.C.R.C. L. 12432 P. 199 East 8.75' PK SW Side 14" Oak (m. 8.58') North 17.57' PK E Side 24" Oak (m. 17.42') SW 66.07' PK E P.P. (m. 66.25') West 50.18' PK S Side TW 13" W. Cherry (m. 50.17')

900 FILE
200

Measure North 3313.5' to E-1 (G.L.O. = 3306.60') (Bramley Hills Sub. = 3287.49') (MDOT (1966) = 3312.35')
Measure South 2637.1' to E-3 (G.L.O. = 2640.0') (Surveys & Tax Maps = 2636.2')

C. Description of monument for corner and accessories established to perpetuate locating the position of the corner:


E-2 Replaced 1/2" rebar with a 4" x 36" concrete monument with brass cap stamped "Oakland County Remonumentation P.S. #25826."

- PK Nail & Oakland Co. Remonumentation Tag in SW Side 14" Oak East 8.58'
- PK Nail & Oakland Co. Remonumentation Tag in E Side 24" Oak North 17.42'
- PK Nail & Oakland Co. Remonumentation Tag in E Side P. Pole S 30° W 66.25'
- PK Nail & Oakland Co. Remonumentation Tag in S Side Twin 14" W. Cherry West 50.17'

The selected location is accepted by the Contractor and is generally accepted by professional surveyors as the best available evidence of the position of the original corner.

Signed by Bruce Antcliff Date 12-24-98
EARTH TECH

Surveyor's Michigan License No. 25826

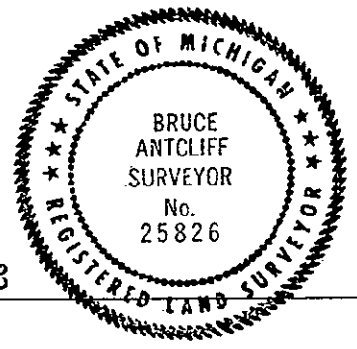

SECTION

LIBER 19350PC888

A. Description of original monument and accessories and/or subsequent restoration:

E-2	1976	Smith	Cert. Survey L. 6759 P. 666	N/A
	1976	Smith	Cert. Survey L. 6699 P. 471	3" Iron Pipe
	1976	Smith	Cert. Survey L. 6699 P. 474 & 477	3" Iron Pipe
	1977	O. Boss	Cert. Survey L. 6982 P. 536	3" Iron Pipe
	1978	Feldhauser	Wilson Estates L. 156 P. 9	N/A
	1983	Soderberg	L.C.R.C. L. 11141 P. 619	1/2" Rerod
	1986	DeKeyser	Bramley Hills Sub.	N/A
	1992	Milletics	L.C.R.C. L. 12432 P. 199	2" Pipe Bent
	N/A	N/A	O.C. Tax Maps	N/A