

CAR 11 1999

LAND CORNER RECORDATION CERTIFICATE
Filing Requirement of Act 74, Mich. P.A. 1970

For corners in


SECTION

Table with columns: Oakland (County), Located in: Lyon Township, Corner Code #. Rows include Public Land Survey, Property Controlling in Section, and Miscellaneous Property in Sec.

\$ 9.00 MISCELLANEOUS RECORDING
\$ 2.00 REMONUMENTATION
17 DEC 98 3:34 P.M. RECEIPT# 518
PAID RECORDED - OAKLAND COUNTY
G. WILLIAM CADDELL
CLERK/REGISTER OF DEEDS
ACT 345, P.A. 1990
APPROVED ON: 12-01-98
OAKLAND COUNTY REMONUMENTATION PEER GROUP COMMITTEE
Register of Deeds Stamp & File Number

- 4. Lot No.
5. Private Claims

I, Bruce Antcliff, in a field survey on May 21 19 98, do hereby certify that under requirements of P.A. 74 Michigan P.A. of 1970, the corner points mentioned in lines 1 and 2 above were in conformance with regulations and rules therefore as required in the current manual of survey instructions of the United States Department of the interior, Bureau of Land Management or by a decree of a Court of Law and/or that the corner points mentioned in lines 3, 4 and 5 above were in conformance with the rules of the Michigan Board of Land Surveyors or by a Decree of a Court of Law; established, re-established, monumented, re-monumented, recovered, found as expressed below:

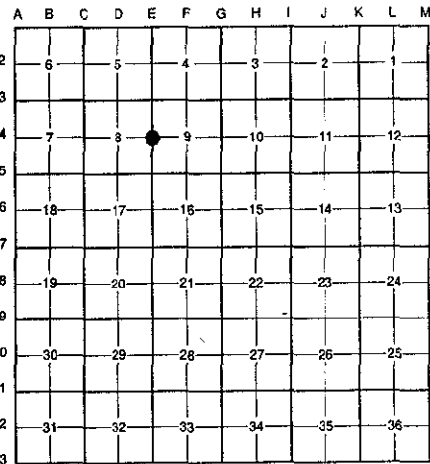

NOTE: Not more than 4 corners, all in the same town and range, may be recorded on this certificate.

A. Description of original monument and accessories and/or subsequent restoration:

Table with 4 columns: Corner Code, Year, Description, Monument Type. Includes entries for 1816, 1934, 1946, and 1970.

(Continued on Back)

B. Description of corner evidence found and/or method applied in restoring or reestablishing corner:

E-4 Found 1/2" iron rod on the C/L of Travis Road (gravel) running East and West. The found 1/2" iron rod checks surveys, L.C.R.C.'s and O.C.R.C. Section Corner Ties from 1934 to the present. Also checks the following witnesses:

- O.C.R.C. Section Corner Ties (1934)
Unrecorded Boundary Survey (1995)
Measure North 2640.9' to E-3 (G.L.O. = 2640.0')
Measure South 2637.9' to E-5 (G.L.O. = 2640.0') (Kostecke Survey (1977) = 2638.68') (Boss Survey (1984) = 2638.06') (Gillespie Survey (1946) = 2638.68')

C. Description of monument for corner and accessories established to perpetuate locating the position of the corner:


E-4 Replaced 1/2" iron rod with a 5/8" x 24" rebar with brass cap stamped "Oakland County Remonumentation P.S. #25826."

- PK Nail & Oakland Co. Remonumentation Tag in W. Side Util. Pole N 05° E 51.84'
PK Nail & Oakland Co. Remonumentation Tag in S Side 26" Oak N 75° E 82.81'
PK Nail & Oakland Co. Remonumentation Tag in W Side 18" Oak S 40° E 30.87'
PK Nail & Oakland Co. Remonumentation Tag in N Side 18" Maple S 80° W 92.81'

The selected location is accepted by the Contractor and is generally accepted by professional surveyors as the best available evidence of the position of the original corner.

Signed by Bruce Antcliff Date 12-10-98
EARTH TECH

Surveyor's Michigan License No. 25826

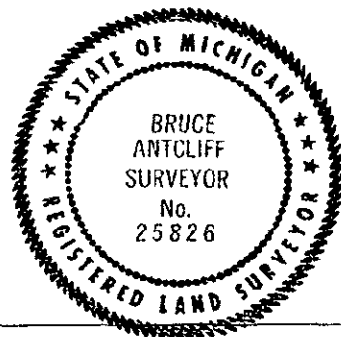

1993

LIBER 19296 RC 571

SECTION

A. Description of original monument and accessories and/or subsequent restoration:

E-4	1973	Roskelly	Cert. Survey L. 6382 P. 439	Iron Pipe
	1974	Campbell	L.C.R.C. L. 6272 P. 111	1/2" Rerod
	1974	Brender	Cert. Survey L. 6272 P. 113	1/2" Rerod
	1977	Roskelly	Property Survey	N/A
	1983	Kostecke	Cert. Survey L.	N/A
	1984	G. Boss	Cert. Survey L. 8717 P. 613	N/A
	1988	DeKeyser	Cert. Survey L. 10597 P. 336	N/A
	1989	DeKeyser	Martindale Meadows No. 3 L. 205 P. 37	N/A
	1991	Roskelly	Survey	1/2" Rerod
	1992	Kostecke	Boundary Survey	1/2" Solid Pipe
	1995	Kostecke	Survey	N/A
	N/A	N/A	O.C. Tax Maps	N/A