

1998 12 1999

LAND CORNER RECORDATION CERTIFICATE
Filing Requirement of Act 74, Mich. P.A. 1970

For corners in

Oakland (County) SECTION Located in: Lyon Township Corner Code #

1. Public Land Survey T 1N R 7E E-6
T R
T R
T R

2. Property Controlling in Section S T R
S T R


3. Miscellaneous Property in Sec. S T R
S T R

4. Lot No. , Recorded Plat

5. Private Claims

\$ 7.00 MISCELLANEOUS RECORDING
\$ 2.00 REMONUMENTATION
17 DEC 98 3:34 P.M. RECEIPT# 518
PAID RECORDED - OAKLAND COUNTY
G. WILLIAM CADDELL
CLERK/REGISTER OF DEEDS
Compliance with
ACT 345, P.A. 1990
APPROVED ON: 12-01-98 JS
OAKLAND COUNTY REMONUMENTATION
PEER GROUP COMMITTEE
Register of Deeds Stamp & File Number

I, Bruce Antcliff, in a field survey on October 22 19 98, do hereby certify that under requirements of P.A. 74 Michigan P.A. of 1970, the corner points mentioned in lines 1 and 2 above were in conformance with regulations and rules therefore as required in the current manual of survey instructions of the United States Department of the interior, Bureau of Land Management or by a decree of a Court of Law and/or that the corner points mentioned in lines 3, 4 and 5 above were in conformance with the rules of the Michigan Board of Land Surveyors or by a Decree of a Court of Law; established, re-established, monumented, re-monumented, recovered, found as expressed below:

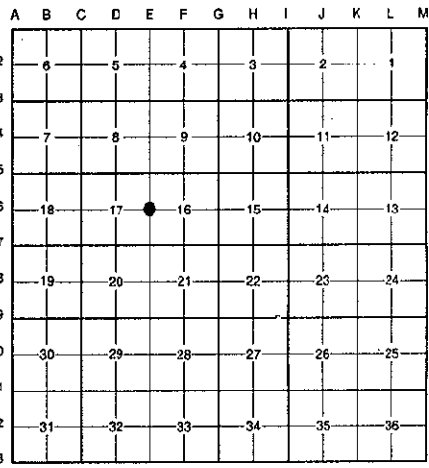

NOTE: Not more than 4 corners, all in the same town and range, may be recorded on this certificate.

A. Description of original monument and accessories and/or subsequent restoration:

E-6	1816	Holmes	G.L.O.	Set Post
	1978	G. Boss	Cert. Survey L. 7402 P. 03	N/A
	N/A	Kemnitz	Survey	N/A
	N/A	N/A	O.C. Tax Maps	N/A

B. Description of corner evidence found and/or method applied in restoring or reestablishing corner:

E-6 Found a "T" iron at the intersection of fence lines running South, East and West and 5' ± West of power lines running North and South. Using E-5 and the irons found on Section line extended line South to E-6 checks line OK. This iron also checks 550.0' South of Southeast corner of Parcel 5-D in Cert. Survey L. 7402 P. 03 by Boss Engineering (1978).

7.00 FILE
2.00

Measure North 2633.8' to E-5 (G.L.O. = 2640.0') (Boss Survey (1978) = 2633.39')
Measure South 2632.4' to E-7 (G.L.O. = 2640.0') (O.C. Tax Maps = 2632.3')

C. Description of monument for corner and accessories established to perpetuate locating the position of the corner:

E-6 Replaced "T" Iron with a 4" x 36" concrete monument with brass cap stamped "Oakland County Remonumentation P.S. #25826."

PK Nail & Oakland Co. Remonumentation Tag in W Side P. Pole N 11° E 123.38'
PK Nail & Oakland Co. Remonumentation Tag in N'ly Side 12" Maple N 50° E 37.65'
PK Nail & Oakland Co. Remonumentation Tag in NE'ly Side 12" Maple N 35° W 28.96'
PK Nail & Oakland Co. Remonumentation Tag in S Side 28" Maple N 75° W 37.87
Nail & Old Washer in NE Cor. Fence Post .70'



The selected location is accepted by the Contractor and is generally accepted by professional surveyors as the best available evidence of the position of the original corner.

Signed by Bruce Antcliff Date 12-10-98
EARTH TECH
Surveyor's Michigan License No. 25826