

OUTSTANDING  
RECORDATION

APR 17 1999

LAND CORNER RECORDATION CERTIFICATE

Filing Requirement of Act 74, Mich. P.A. 1970 \$ 9.00

MISCELLANEOUS RECORDING

For corners in SECTION  
Oakland (County)

Located in: Lyon Township Corner Code #


- 1. Public Land Survey T 1N R 7E E-7
2. Property Controlling in Section S T R
3. Miscellaneous Property in Sec. S T R

\$ 2.00 REMONUMENTATION
17 DEC 98 3:35 P.M. RECEIPT# 510
PAID RECORDED - OAKLAND COUNTY
G. WILLIAM CAIDELL
CLERK/REGISTER OF DEEDS

Compliance with ACT 345, P.A. 1990
APPROVED ON: 12-01-98 JS
OAKLAND COUNTY REMONUMENTATION PEER GROUP COMMITTEE
Register of Deeds Stamp & File Number

- 4. Lot No. Recorded Plat
5. Private Claims

I, Bruce Antcliff, in a field survey on June 16 19 98, do hereby certify that under requirements of P.A. 74 Michigan P.A. of 1970, the corner points mentioned in lines 1 and 2 above were in conformance with regulations and rules therefore as required in the current manual of survey instructions of the United States Department of the interior, Bureau of Land Management or by a decree of a Court of Law and/or that the corner points mentioned in lines 3, 4 and 5 above were in conformance with the rules of the Michigan Board of Land Surveyors or by a Decree of a Court of Law; established, re-established, monumented, re-monumented, recovered, found as expressed below:

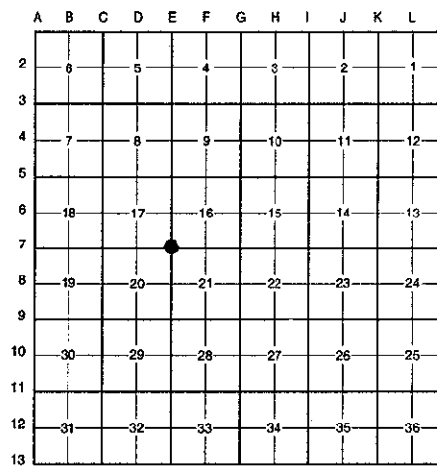

NOTE: Not more than 4 corners, all in the same town and range, may be recorded on this certificate.

A. Description of original monument and accessories and/or subsequent restoration:

E-7 1816 Holmes G.L.O. Set Post
1983 Munzel Survey N/A
1983 Kostecke Survey 3/4" Pipe

(Continued on Back)

B. Description of corner evidence found and/or method applied in restoring or reestablishing corner:

E-7 Found 1" pipe on the C/L of 11 Mile Road (gravel) running East and West on line of a tree row running North and South. The found 1" pipe checks surveys and L.C.R.C.'s from 1983 to the present. Also checks the following witnesses:

- L.C.R.C. L. 8659 P. 893 (1984) Unrecorded Kostecke Survey (1994)
North 28.05' Spike in 15" Cherry Tree (m. 28.12') NW 28.12' to 30" Twin Cherry (m. 28.12')
S 70° W 56.0' Spike in P.Pole (m. 57.10') NE 25.46' to 16" Ash (m. 25.45')
SE 25.00' to 20" Hickory (m. 24.98')

- Measure North 2632.4' to E-6 (G.L.O. = 2640.0') (O.C. Tax Maps = 2632.3')
Measure South 2631.8' to E-8 (G.L.O. = 2640.0') (Boss Survey (1991) = 2631.98')
Measure East 2630.5' to F-7 (G.L.O. = 2638.68') (Brady Unrec. Survey (1991) = 2630.02')
Measure West 2647.7' to D-7 (G.L.O. = 2641.65') (Boss Survey (1991) = 2647.67') (Boss Survey (1993) = 2647.68')

C. Description of monument for corner and accessories established to perpetuate locating the position of the corner:

E-7 Replaced 1" pipe with a 5/8" x 24" rebar with brass cap stamped "Oakland County Remonumentation P.S. #25826."


- PK Nail & Oakland Co. Remonumentation Tag in SW Side 16" Ash N 35° W 39.28'
PK Nail & Oakland Co. Remonumentation Tag in SE Side 20" Ash N 55° E 25.45'
PK Nail & Oakland Co. Remonumentation Tag in S'y Side 14" Stump N 83° E 110.55'
PK Nail & Oakland Co. Remonumentation Tag in E'y Side 22" Hickory S 15° E 24.98'
PK Nail & Oakland Co. Remonumentation Tag in W Side Wood Fence Post North 25.77'

The selected location is accepted by the Contractor and is generally accepted by professional surveyors as the best available evidence of the position of the original corner.

Signed by Bruce Antcliff Date 12-10-98

EARTH TECH

Surveyor's Michigan License No. 25826

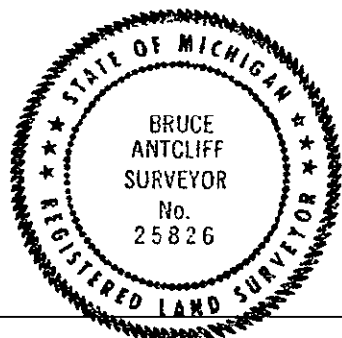

900 FILE
200


MAR 12 1999

LIBER 19296 PC 576

SECTION

A. Description of original monument and accessories and/or subsequent restoration:

E-7	1984	Lapham	L.C.R.C. L. 8659 P. 893	Iron
	1984	Kostecke	Survey	3/4" Pipe
	1984	Munzel	Survey	N/A
	1985	Munzel	Survey (2)	N/A
	1986	Kostecke	Survey	3/4" Pipe
	1989	G. Boss	Cert. Survey L. 11645 P. 497	N/A
	1990	Green	Survey	3/4" Pipe
	1991	Brady	Survey	N/A
	1991	Kostecke	Cert. Survey L. 11855 P. 168	2" Iron Pipe
	1994	Kostecke	Survey	1" Pipe
	N/A	N/A	O.C. Tax Maps	N/A