

LIBER 19296PG577

SECTION

LAND CORNER RECORDATION CERTIFICATE
Filing Requirement of Act 74, Mich. P.A. 1970

For corners in

Oakland (County)	Located in: Lyon Township	Corner Code #
1. Public Land Survey	T <u>1N</u> R <u>7E</u>	<u>E-8</u>
	T _____ R _____	_____
	T _____ R _____	_____
	T _____ R _____	_____
2. Property Controlling in Section	S _____ T _____ R _____	_____
	S _____ T _____ R _____	_____
3. Miscellaneous Property in Sec.	S _____ T _____ R _____	_____
	S _____ T _____ R _____	_____

\$ 9.00 MISCELLANEOUS RECORDING

\$ 2.00 REMONUMENTATION

17 DEC 98 3:35 P.M. RECEIPT# 518

PAID RECORDED - OAKLAND COUNTY

G. WILLIAM CADDELL

CLERK/REGISTER OF DEEDS

Compliance with
ACT 345, P.A. 1990

APPROVED ON: 12-01-98 OS

OAKLAND COUNTY REMONUMENTATION

PEER GROUP COMMITTEE

Register of Deeds Stamp & File Number

- 4. Lot No. _____, Recorded Plat _____
- 5. Private Claims _____

I, Bruce Antcliff, in a field survey on October 22 19 98, do hereby certify that under requirements of P.A. 74 Michigan P.A. of 1970, the corner points mentioned in lines 1 and 2 above were in conformance with regulations and rules therefore as required in the current manual of survey instructions of the United States Department of the interior, Bureau of Land Management or by a decree of a Court of Law and/or that the corner points mentioned in lines 3, 4 and 5 above were in conformance with the rules of the Michigan Board of Land Surveyors or by a Decree of a Court of Law; established, re-established, monumented, re-monumented, recovered, found as expressed below:

NOTE: Not more than 4 corners, all in the same town and range, may be recorded on this certificate.

A. Description of original monument and accessories and/or subsequent restoration:

E-8	1816	Holmes	G.L.O.	Set Post
	1971	Wilson	Cert. Survey L. 5770 P. 789	1" Iron Pipe
	1974	O. Boss	Cert. Survey L. 6290 P. 96	3/4" Pipe

(Continued on Back)

B. Description of corner evidence found and/or method applied in restoring or reestablishing corner:

E-8 Found a 1" iron pipe 3.3' West of power lines running North and South on occupation line running South and East. The found rered checks surveys and L.C.R.C.'s from 1971 to the present. Also checks the following witnesses:

- | | |
|------------------------------------------------|---------------------------------------------------------|
| Cert. Survey L. 6290 P. 96 (1974) | Cert. Survey L. 14965 P. 715 (1994) |
| S 60° E 3.88' Nail N/S Power Pole (m. 3.9') | S 45° E 3.80' Nail N/S P. Pole (m. 3.90') |
| N 75° W 35.0' Nail S/S 8" Hickory (m. 34.98') | N 70° E 34.10' Nail NW/S 10" Hickory (m. 34.08') |
| N 60° E 34.09' Nail N/S 8" Hickory (m. 34.08') | N 32° E 81.80' Nail W/S 12" Hickory (m. 81.82') |
| | N 80° W 35.05' Nail, Cap #13574 10" Hickory (m. 34.98') |

Measure North 2631.8' to E-7 (G.L.O. = 2640.0') (Boss Survey (1991) = 2631.98') (O.C. Tax Maps = 2632.3')
Measure South 2634.2' to E-9 (G.L.O. = 2640.0') (Boss Survey (1974) = 2634.43')



C. Description of monument for corner and accessories established to perpetuate locating the position of the corner:

E-8 Replaced 1" iron pipe with a 4" x 36" concrete monument with brass cap stamped "Oakland County Remonumentation P.S. #25826."

PK Nail & Oakland Co. Remonumentation Tag in N Side P. Pole S 45° E 3.90'
PK Nail & Oakland Co. Remonumentation Tag in NW Side 10" Hickory N 70° E 34.08'
PK Nail & Oakland Co. Remonumentation Tag in W Side 12" Hickory N 32° E 81.82'
PK Nail & Oakland Co. Remonumentation Tag in S Side 12" Hickory N 80° W 34.98'

The selected location is accepted by the Contractor and is generally accepted by professional surveyors as the best available evidence of the position of the original corner.

Signed by Bruce Antcliff Date 12-10-98
EARTH TECH
Surveyor's Michigan License No. 25826

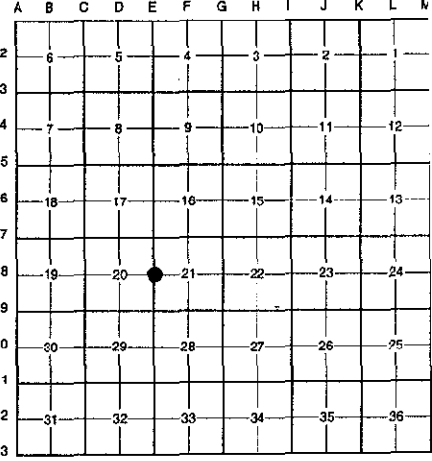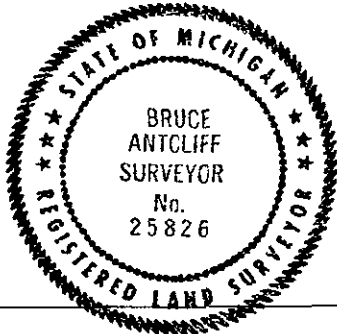

DE 17 98 31 37 00

900 FILE
200

Case No. 1939

SECTION

LIBER 19296 RC 578

A. Description of original monument and accessories and/or subsequent restoration:

E-8	1989	G. Boss	Survey	1" Pipe
	1989	G. Boss	Cert. Survey L. 11645 P. 497	1" Pipe
	1990	G. Boss	Survey	1" Pipe
	1991	G. Boss	Cert. Survey L. 11553 P. 48	N/A
	1994	G. Boss	Cert. Survey L. 14965 P. 715	1" Pinch Pipe
	1995	G. Boss	Cert. Survey L. 16936 P. 212	N/A
	N/A	N/A	O.C. Tax Maps	N/A