

SECTION

LAND CORNER RECORDATION CERTIFICATE
Filing Requirement of Act 74, Mich. P.A. 1970

\$ 9.00 MISCELLANEOUS RECORDING
\$ 2.00 REMONUMENTATION
3 JAN 99 8:27 A.M. RECEIPT# 8A
PAID RECORDED - OAKLAND COUNTY
G. WILLIAM CADRELL
CLERK/REGISTER OF DEEDS

For corners in

Oakland (County)	Located in: Lyon Township	Corner Code #
1. Public Land Survey	T <u>1N</u> R <u>7E</u>	<u>E-9</u>
	T _____ R _____	_____
	T _____ R _____	_____
	T _____ R _____	_____
2. Property Controlling in Section	S _____ T _____ R _____	_____
	S _____ T _____ R _____	_____
3. Miscellaneous Property in Sec.	S _____ T _____ R _____	_____
	S _____ T _____ R _____	_____
4. Lot No. _____, Recorded Plat _____		
5. Private Claims _____		

Compliance with
ACT 345, P.A. 1990
APPROVED ON: 12-16-98 JS
OAKLAND COUNTY REMONUMENTATION
PEER GROUP COMMITTEE
Register of Deeds Stamp & File Number

I, Bruce Antcliff, in a field survey on June 18 19 98, do hereby certify that under requirements of P.A. 74 Michigan P.A. of 1970, the corner points mentioned in lines 1 and 2 above were in conformance with regulations and rules therefore as required in the current manual of survey instructions of the United States Department of the interior, Bureau of Land Management or by a decree of a Court of Law and/or that the corner points mentioned in lines 3, 4 and 5 above were in conformance with the rules of the Michigan Board of Land Surveyors or by a Decree of a Court of Law; established, re-established, monumented, re-monumented, recovered, found as expressed below:

NOTE: Not more than 4 corners, all in the same town and range, may be recorded on this certificate.

A. Description of original monument and accessories and/or subsequent restoration:

E-9	1816	Holmes	G.L.O.	Set Post
	1963	N/A	O.C.R.C. Sec. Cor. Ties	1" Bar
	1971	Garlock	Cert. Survey L. 5771 P. 767	1" Iron Rod

(Continued on Back)

B. Description of corner evidence found and/or method applied in restoring or reestablishing corner:

E-9 Found 1" iron rod in a monument box at the C/L intersection of 10 Mile Road (bit.) running East and West and Griswold Road (gravel) running South. The found rered checks surveys, L.C.R.C.'s and O.C.R.C. Section Corner Ties from 1963 to the present. Also checks the following witnesses:

O.C.R.C. Sec. Cor. Ties (1963)	L.C.R.C. L. 5771 P. 776 (1971)	Cert. Survey L. 10730 P. 182 (198_)
SE 64.6' 26" Maple (m. 64.8')	S 30° E 66.05' T. Pole SP C/L W/S (m. 66.09')	N 05° W 51.30' Tag/Nail E/S P. Pole (m. 51.24')
	S 45° W 77.88' P. Pole SP C/L W/S (m. 77.42')	N 60° E 64.85' Tag NE Side 25" Hickory (Maple) (m. 64.80')
	North 51.32' P. Pole SP C/L W/S (m. 51.24')	S 45° W 77.50' Nail/Tag SE Side P. Pole (m. 77.42')

Measure North 2634.2' to E-8 (G.L.O. = 2640.0')
Measure South 2635.32' to E-10 (G.L.O. = 2640.0') (Garlock Survey (1971) = 2635.88) (Newman Survey (1995) = 2635.88)
Measure East 2645.2' to F-9 (G.L.O. = 2656.5') (Newman Survey (1995) = 2645.60')
Measure West 2663.8' to D-9 (G.L.O. = 2659.8') (Boss Surveys (1989) = 2664.03')

C. Description of monument for corner and accessories established to perpetuate locating the position of the corner:



E-9 Replaced 1" iron with a 5/8" x 24" rebar with brass cap stamped "Oakland County Remonumentation P.S. #25826" in an existing monument box.

- PK Nail & Oakland Co. Remonumentation Tag in W Side P. Pole S 30° E 66.09'
- PK Nail & Oakland Co. Remonumentation Tag in W Side P. Pole S 45° W 77.42'
- PK Nail & Oakland Co. Remonumentation Tag in E Side P. Pole North 51.24'
- PK Nail & Oakland Co. Remonumentation Tag in NE Side 30" Maple S 50° E 64.80'

The selected location is accepted by the Contractor and is generally accepted by professional surveyors as the best available evidence of the position of the original corner.

Signed by Bruce Antcliff Date 12-22-98
EARTH TECH

Surveyor's Michigan License No. 25826

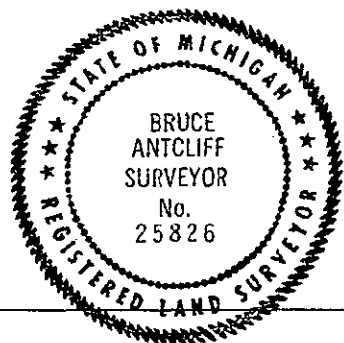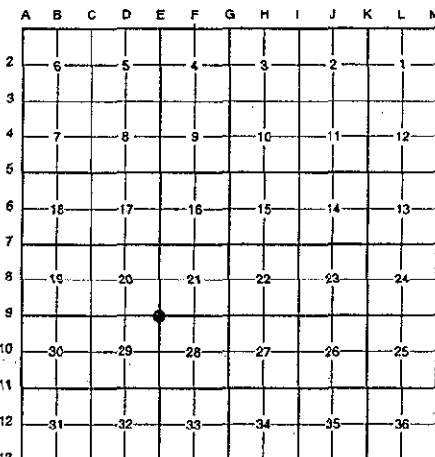

LIBER 19350PG892

CLINTON
RECORD DEPARTMENT

JAN 13 1999

SECTION

A. Description of original monument and accessories and/or subsequent restoration:

E-9	1971	Wilson	Cert. Survey L. 5770 P. 789	1" Iron Rod
	1971	Wilson	L.C.R.C. L. 5754 P. 242	1" Iron Rod
	1971	Garlock	Cert. Survey L. 5771 P. 768	1" Iron Rod
	1971	Garlock	Cert. Survey L. 5771 P. 776	1" Iron Rod
	1971	Garlock	Cert. Survey L. 5771 P. 772	1" Iron Rod
	1971	Garlock	L.C.R.C. L. 5771 P. 776	1" Iron Rod
	1974	O. Boss	Cert. Survey L. 6420 P. 321	3/4" Iron
	1974	O. Boss	Cert. Survey L. 6328 P. 668	N/A
	1974	O. Boss	Cert. Survey L. 6290 P. 96	3/4" Iron
	1974	O. Boss	Cert. Survey L. 6328 P. 672	Iron Rod
	1976	Garlock	Cert. Survey L. 7105 P. 738	1" Iron Rod
	1976	O. Boss	L.C.R.C. L. 6616 P. 817	3/4" Iron
	1976	O. Boss	L.C.R.C. L. 6616 P. 815	Iron
	1976	O. Boss	L.C.R.C. L. 6616 P. 813	Iron
	1982	O. Boss	Cert. Survey L. 8313 P. 572	3/4" Iron
	1987	Kostecke	Cert. Survey L. 10004 P. 361	Iron Pipe
	198_	G. Boss	Cert. Survey L. 10730 P. 182	3/4" Solid Bar in Mon. Box
	1989	G. Boss	Cert. Survey L. 11512 P. 269	N/A
	1989	G. Boss	Cert. Survey L. 11236 P. 342	3/4" Iron Bar
	1991	G. Boss	Cert. Survey L. 12373 P. 027	N/A
	N/A	N/A	O.C. Tax Maps	N/A