

SUBJECT
RECORDING


LIBER 19296PG579

1999

LAND CORNER RECORDATION CERTIFICATE
Filing Requirement of Act 74, Mich. P.A. 1970

\$ 9.00 MISCELLANEOUS RECORDING
\$ 2.00 REMONUMENTATION
17 DEC 98 3:35 P.M. RECEIPT# 518
PAID RECORDED - OAKLAND COUNTY
G. WILLIAM CADDELL
CLERK/REGISTER OF DEEDS
Compliance with
ACT 345, P.A. 1990
APPROVED ON: 11-24-98 JS
OAKLAND COUNTY REMONUMENTATION
PEER GROUP COMMITTEE
Register of Deeds Stamp & File Number

For corners in SECTION
Oakland (County)
Located in: Lyon Township Corner Code #
1. Public Land Survey T 1N R 7E E-10
T R
T R
T R
2. Property Controlling S T R
in Section S T R
3. Miscellaneous S T R
Property in Sec. S T R
4. Lot No. , Recorded Plat
5. Private Claims

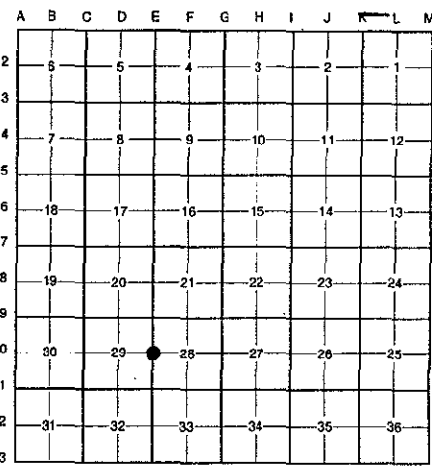

I, Bruce Antcliff, in a field survey on July 27 19 98, do hereby certify that under requirements of P.A. 74 Michigan P.A. of 1970, the corner points mentioned in lines 1 and 2 above were in conformance with regulations and rules therefore as required in the current manual of survey instructions of the United States Department of the Interior, Bureau of Land Management or by a decree of a Court of Law and/or that the corner points mentioned in lines 3, 4 and 5 above were in conformance with the rules of the Michigan Board of Land Surveyors or by a Decree of a Court of Law; established, re-established, monumented, re-monumented, recovered, found as expressed below:

NOTE: Not more than 4 corners, all in the same town and range, may be recorded on this certificate.


A. Description of original monument and accessories and/or subsequent restoration:
E-10 1816 Holmes G.L.O. Set Post
N/A Hughes Survey N/A
(Continued on Back)

B. Description of corner evidence found and/or method applied in restoring or reestablishing corner:
E-10 Found 3/4" iron rod on the C/L of Griswold Road (gravel) running North and South. In 1971 Charles Garlock, finding nothing at this corner, set a 1/2" x 18" rered at the midpoint between E-9 and E-11 and filed L.C.R.C. L. 5771 P. 778 (no witnesses remain from this certificate). Meas. North 2644.86' to E-9 Meas. South 2625.78' to E-11 Total E-9 to E-11 = 5270.64' 1/2 = 2635.32' 3/4" iron is 9.54' South of 1971 location. Found a second iron (1/2" rod) 9.55' North of the 3/4" iron on the C/L of Griswold Road. This iron checks 33' West of iron found along East right-of-way of Griswold Road and is on line of stakes running East on the East-West 1/4 line and the North line of parcel 8-M of Manzel's 1989 Survey. Accepted 1/2" iron rod as corner.

Measure North 2635.31' to E-9 (G.L.O. = 2640.0') (Garlock Survey (1971) = 2635.88) (Newman Survey (1995) = 2635.88)
Measure South 2635.31' to E-11 (G.L.O. = 2640.0') (Hughes Survey = 2627.90')

500 Fil
200

C. Description of monument for corner and accessories established to perpetuate locating the position of the corner:
E-10 Replaced 1/2" iron rod with a 5/8" x 24" rebar with brass cap stamped "Oakland County Remonumentation P.S. #25826."
PK Nail & Oakland Co. Remonumentation Tag in NW Side 8" Elm N 60° E 25.29'
PK Nail & Oakland Co. Remonumentation Tag in SE Side 42" Oak S 15° E 57.61'
PK Nail & Oakland Co. Remonumentation Tag in NW Side 10" Elm S 15° W 33.96'
PK Nail & Oakland Co. Remonumentation Tag in E Face S Fence Post N 15° W 42.77'
Capped Rerod #10699 East 33.09'
3/4" Iron Pipe S 08° E 9.55'

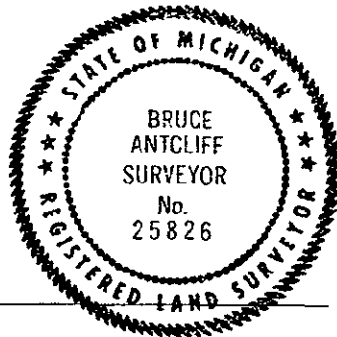

The selected location is accepted by the Contractor and is generally accepted by professional surveyors as the best available evidence of the position of the original corner.

Signed by Bruce Antcliff Date 12-10-98
EARTH TECH

Surveyor's Michigan License No. 25826

RECORDS

LIBER 19296 RC 580

1939

SECTION

A. Description of original monument and accessories and/or subsequent restoration:

E-10	1971	Garlock	Cert. Survey L. 5771 P. 766	Set 1/2" Iron Rerod
	1971	Garlock	L.C.R.C. L. 5771 P. 778	Set 1/2" Rerod
	1974	O. Boss	Cert. Survey L. 6328 P. 668	N/A
	1976	O. Boss	L.C.R.C. L. 6616 P. 813	Iron Pipe
	1989	Stephens	L.C.R.C. L. 11381 P. 063	3/4" Pipe
	1989	Munzel	Survey	N/A
	1995	Kostecke	Survey	N/A
	1995	Newman	Survey	1/2" Rerod
	N/A	N/A	O.C. Tax Maps	N/A