

LIBER 19296PG582

SECTION

LAND CORNER RECORDATION CERTIFICATE

Filing Requirement of Act 74, Mich. P.A. 1970 \$ 7.00 MISCELLANEOUS RECORDING


For corners in

<u>Oakland</u> (County)	Located in: Lyon Township	Corner Code #
1. Public Land Survey	T <u>1N</u> R <u>7E</u>	<u>E-12</u>
	T _____ R _____	_____
	T _____ R _____	_____
	T _____ R _____	_____
2. Property Controlling in Section	S _____ T _____ R _____	_____
	S _____ T _____ R _____	_____
3. Miscellaneous Property in Sec.	S _____ T _____ R _____	_____
	S _____ T _____ R _____	_____

\$ 2.00 REMONUMENTATION
 17 DEC 98 3:33 P.M. RECEIPT# 518
 PAID RECORDED - OAKLAND COUNTY
 G. WILLIAM CADDELL
 CLERK/REGISTER OF DEEDS
 Compliance with
 ACT 345, P.A. 1990
 APPROVED ON: 11-10-98 JS
 OAKLAND COUNTY REMONUMENTATION
 PEER GROUP COMMITTEE
 Register of Deeds Stamp & File Number 170321

- 4. Lot No. _____, Recorded Plat _____
- 5. Private Claims _____

I, Bruce Antcliff, in a field survey on July 27 19 98, do hereby certify that under requirements of P.A. 74 Michigan P.A. of 1970, the corner points mentioned in lines 1 and 2 above were in conformance with regulations and rules therefore as required in the current manual of survey instructions of the United States Department of the interior, Bureau of Land Management or by a decree of a Court of Law and/or that the corner points mentioned in lines 3, 4 and 5 above were in conformance with the rules of the Michigan Board of Land Surveyors or by a Decree of a Court of Law; established, re-established, monumented, re-monumented, recovered, found as expressed below:

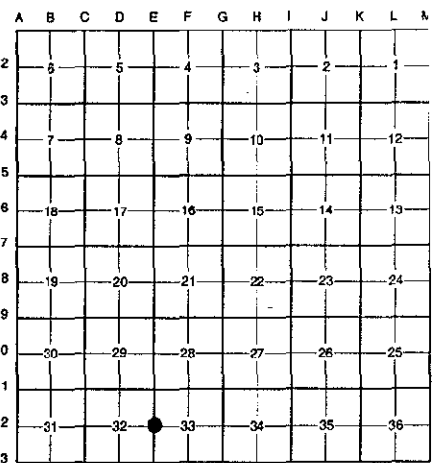

NOTE: Not more than 4 corners, all in the same town and range, may be recorded on this certificate.

A. Description of original monument and accessories and/or subsequent restoration:

E-12	1816	Holmes	G.L.O.	Set Post
	1987	Newman	L.C.R.C. L. 11604 P. 639	1" Sq. Bolt
	1990	Kostecke	Cert. Survey L. 11445 P. 681	Iron Rod
	1995	G. Boss	Cert. Survey L. 16936 P. 220	N/A
	N/A	N/A	O.C. Tax Maps	N/A

B. Description of corner evidence found and/or method applied in restoring or reestablishing corner:

E-12 Found a 1" square bolt 1.0' deep 1.5' East of the C/L of Griswold (gravel) running North and South and on line of a tree row running West. Checks the following witnesses:

L.C.R.C. L. 11604 P. 639 (1987)	Cert. Suvey L. 11445 P. 681 (1990)	L.C.R.C. L. 11604 P. 639 (1990)
N 60° W 24.85' P. Pole (m. 24.83')	NE 14.24' to 24" Oak (m. 14.36')	N 60° W 24.85' P. Pole (m. 24.38')
East 33.00 Set Iron (m. 32.95')	NW 39.85' to 36" Oak (m. 39.79')	East 33.00' Iron (m. 32.95')
N 50° E 14.40' 27" Oak (m. 14.36')		N 50° E 14.40' 27" Oak (m. 14.36')
N 30° W 39.85' 36" Oak (m. 39.79')		N 30° W 39.85' 36" Oak (m. 39.79')

Measure North 2635.59' to E-11 (G.L.O. = 2640.0')
 Measure South 2629.59' to E-13 (G.L.O. = 2640.0') (O.C. Tax Maps = 2628.78' & 2629.27') (Boss Survey (1995) = 2629.55')


C. Description of monument for corner and accessories established to perpetuate locating the position of the corner:

E-12 Replaced the 1" bolt with a 5/8" x 24" rebar with brass cap stamped "Oakland County Remonumentation P.S. #25826."

- PK Nail & Oakland Co. Remonumentation Tag in S Side P. Pole N 60° W 24.83'
- Capped Iron #RLS 10067/24607 East 32.95'
- PK Nail & Oakland Co. Remonumentation Tag in N'ly Side 28" Oak N 50° E 14.36'
- PK Nail & Oakland Co. Remonumentation Tag in NE'ly Side 36" Oak N 30° W 39.79'
- PK Nail & Oakland Co. Remonumentation Tag in NE'ly Side 8" Elm S 11° E 54.76'

The selected location is accepted by the Contractor and is generally accepted by professional surveyors as the best available evidence of the position of the original corner.

Signed by Bruce Antcliff Date 12-10-98
 EARTH TECH

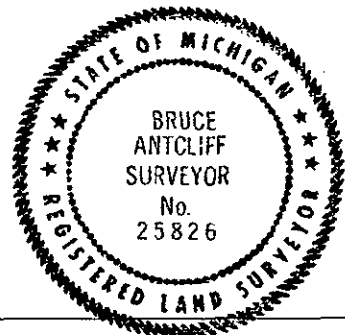

Surveyor's Michigan License No. 25826