

MAR 22 1999

LAND CORNER RECORDATION CERTIFICATE
Filing Requirement of Act 74, Mich. P.A. 1970

For corners in SECTION
Oakland
(County)

Located in: Lyon Township
Corner Code #

- 1. Public Land Survey T 1N R 7E E-13
T _____ R _____
T _____ R _____
T _____ R _____
- 2. Property Controlling in Section S _____ T _____ R _____
S _____ T _____ R _____
- 3. Miscellaneous S _____ T _____ R _____
Property in Sec. S _____ T _____ R _____

\$ 9.00 MISCELLANEOUS RECORDING
\$ 2.00 REMONUMENTATION
17 DEC 98 3:35 P.M. RECEIPT# 519
PAID RECORDED - OAKLAND COUNTY
G. WILLIAM CADDELL
CLERK/REGISTER OF DEEDS
ACT 345, P.A. 1990

APPROVED ON: 11-10-98 JS
OAKLAND COUNTY REMONUMENTATION
PEER GROUP COMMITTEE

Register of Deeds Stamp & File Number

DE 17 98 3 35 P M

- 4. Lot No. _____, Recorded Plat _____
- 5. Private Claims _____

I, Bruce Antcliff, in a field survey on July 27 19 98, do hereby certify that under requirements of P.A. 74 Michigan P.A. of 1970, the corner points mentioned in lines 1 and 2 above were in conformance with regulations and rules therefore as required in the current manual of survey instructions of the United States Department of the interior, Bureau of Land Management or by a decree of a Court of Law and/or that the corner points mentioned in lines 3, 4 and 5 above were in conformance with the rules of the Michigan Board of Land Surveyors or by a Decree of a Court of Law; established, re-established, monumented, re-monumented, recovered, found as expressed below:

NOTE: Not more than 4 corners, all in the same town and range, may be recorded on this certificate.

A. Description of original monument and accessories and/or subsequent restoration:

E-13 1816 Holmes G.L.O. Set Post
1973 Roskelly Cert. Survey L. 6259 P. 862 N/A

(Continued on Back)

Records indicate this corner is not common with E-1, T1S, R7E

B. Description of corner evidence found and/or method applied in restoring or reestablishing corner:

E-13 Found a railroad spike on the C/L of Griswold Street (gravel) running North and .5' South of the C/L of 8 Mile Road (bit.) running East and West, which checks location of iron set by Tietsma (1979) G.L.O. distance East of E-1, T1S, R7E. Also checks the following witnesses:

L.C.R.C. L. 7649 P. 588 (1979) Cert. Survey L. 11445 P. 681 (1990)
S 34° W 32.96' 36" W. Oak (m. 32.82') ESW 32.96' to 36" Oak (m. 32.82')
S 66° W 74.80' 30" W. Oak (m. 74.75') WSW 74.8' to 30" Oak (m. 74.75')
West 260.70' of NW Cor. Sec. 4 (m. 260.65')

Measure North 2629.59' to E-12 (G.L.O. = 2640.0') (O.C. Tax Maps = 2628.78') (Boss Survey (1995) = 2629.55')
Measure East 2649.57' to F-13 (G.L.O. = 2640.0')
Measure West 2635.33' to D-13 (G.L.O. = 2640.0') (Boss Survey (1995) = 2635.25')
(O.C. Tax Maps = 2632.19')

C. Description of monument for corner and accessories established to perpetuate locating the position of the corner:

E-13 Replaced railroad spike with a 5/8" x 24" rebar with brass cap stamped "Oakland County Remonumentation P.S. #25826." Also set a new monument box.

PK Nail & Oakland Co. Remonumentation Tag in NW'y Side 36" Oak S 34° W 32.82'
PK Nail & Oakland Co. Remonumentation Tag in SE'y Side 36" Oak S 66° W 74.75'
PK Nail & Oakland Co. Remonumentation Tag in W Side 6" Dia. Wood Fence Post N 47° E 58.30'
PK Nail & Oakland Co. Remonumentation Tag in NE'y Side P. Pole S 62° E 83.47'
E-1, T1S, R7E, West 260.65'


The selected location is accepted by the Contractor and is generally accepted by professional surveyors as the best available evidence of the position of the original corner.

Signed by Bruce Antcliff Date 12-10-98
EARTH TECH

Surveyor's Michigan License No. 25826

	A	B	C	D	E	F	G	H	I	J	K	L	M
2	6		5		4		3		2		1		
3													
4	7		8		9		10		11		12		
5													
6	18		17		16		15		14		13		
7													
8	19		20		21		22		23		24		
9													
10	30		29		28		27		26		25		
11													
12	31		32		33		34		35		36		
13													

5.00 FILE
2.00

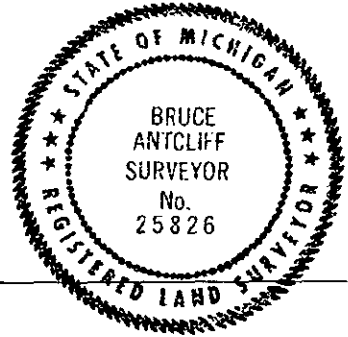

CITY OF
RECORD SECTION

MAY 2 1899

SECTION

LIBER 19296 P. 584

A. Description of original monument and accessories and/or subsequent restoration:

E-13	1979	Emig	L.C.R.C. L. 7489 P. 484	Iron Pipe in Well
	1979	Fahrner	L.C.R.C. L. 7700 P. 769	1" Iron Pipe
	1979	Tietsema	L.C.R.C. L. 7649 P. 588	1" x 3' Iron Pipe
	1990	Kostecke	Cert. Survey L. 11445 P. 681	Iron Rod
	1995	G. Boss	Cert. Survey L. 16936 P. 220	N/A
	1995	G. Boss	Cert. Survey L. 16936 P. 217	N/A
	N/A	N/A	O.C. Tax Maps	N/A