

MAY 1 1999

LIBER 19296PG587

LAND CORNER RECORDATION CERTIFICATE

Filing Requirement of Act 74, Mich. P.A. 1970 \$ 9.00 MISCELLANEOUS RECORDING


For corners in SECTION

<u>Oakland</u> (County)	Located in: Lyon Township	Corner Code #
1. Public Land Survey	T <u>1N</u> R <u>7E</u>	<u>F-7</u>
	T _____ R _____	_____
	T _____ R _____	_____
	T _____ R _____	_____
2. Property Controlling in Section	S _____ T _____ R _____	_____
	S _____ T _____ R _____	_____
3. Miscellaneous Property in Sec.	S _____ T _____ R _____	_____
	S _____ T _____ R _____	_____

\$ 2.00 REMONUMENTATION
 17 DEC 98 3:36 P.M. RECEIPT# 518
 PAID RECORDED - OAKLAND COUNTY
 G. WILLIAM CATDELL
 CLERK/REGISTER OF DEEDS
 Compliance with
 ACT 345, P.A. 1990
 APPROVED ON: 11-10-98 JS
 OAKLAND COUNTY REMONUMENTATION
 PEER GROUP COMMITTEE
 Register of Deeds Stamp & File Number

- 4. Lot No. _____, Recorded Plat _____
- 5. Private Claims _____

I, Bruce Antcliff, in a field survey on June 16 19 98, do hereby certify that under requirements of P.A. 74 Michigan P.A. of 1970, the corner points mentioned in lines 1 and 2 above were in conformance with regulations and rules therefore as required in the current manual of survey instructions of the United States Department of the interior, Bureau of Land Management or by a decree of a Court of Law and/or that the corner points mentioned in lines 3, 4 and 5 above were in conformance with the rules of the Michigan Board of Land Surveyors or by a Decree of a Court of Law; established, re-established, monumented, re-monumented, recovered, found as expressed below:

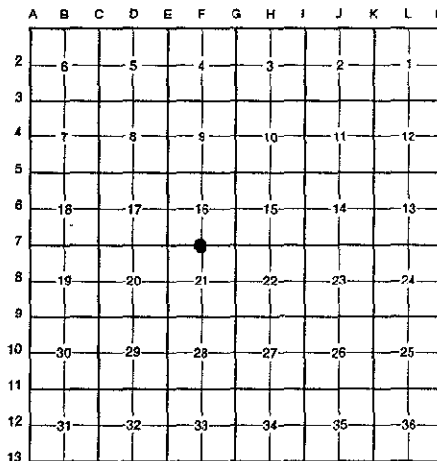

NOTE: Not more than 4 corners, all in the same town and range, may be recorded on this certificate.

A. Description of original monument and accessories and/or subsequent restoration:

F-7	1816	Holmes	G.L.O.	Set Post
	1984	Kostecke	Survey	N/A
	1986	Kostecke	Survey	N/A

(Continued on Back)

B. Description of corner evidence found and/or method applied in restoring or reestablishing corner:

F-7 Found two 1/2" rebars (0.17' apart N-S) 1' South of the C/L of 11 Mile Road (gravel) running East and West on line of a tree row and fence line running South and a tree row running North. The North rebar checks record witness 0.10'±. Held this iron for corner. Also checks the following witnesses:

Unrecorded Survey (1984)	Cert. Survey L. 11855 P. 168 (1991)
N 45° E 36.9' to U. P. (m. 36.78')	NE 36.9' to U.P. (m. 36.78')
S 33.4' to Bent Iron Pipe (m. 33.27')	S 33.4' to Bent Iron Pipe (m. 33.27')

Measure East 2635.38' to G-7 (G.L.O. = 2638.68')
 Measure West 2630.52' to E-7 (G.L.O. = 2638.68') (Brady Unrec. Survey (1991) = 2630.02')
 (O.C. Tax Maps = 2626.60' & 2623.80')(Kostecke (1986) = 2631.60')

C. Description of monument for corner and accessories established to perpetuate locating the position of the corner:


F-7 Replaced 1/2" rebars with a 5/8" x 24" rebar with brass cap stamped "Oakland County Remonumentation P.S. #25826."

- PK Nail & Oakland Co. Remonumentation Tag in NE Side 18" Walnut S 67° E 79.78'
- PK Nail & Oakland Co. Remonumentation Tag in NW Side P. Pole N 35° E 33.78'
- PK Nail & Oakland Co. Remonumentation Tag in N Side 14" Ash S 79° W 54.87'
- PK Nail & Oakland Co. Remonumentation Tag in 6" Ash N 20° W
- 1" Iron Pipe S 13° W 33.27'

The selected location is accepted by the Contractor and is generally accepted by professional surveyors as the best available evidence of the position of the original corner.

Signed by Bruce Antcliff Date 12-10-98
 EARTH TECH

Surveyor's Michigan License No. 25826

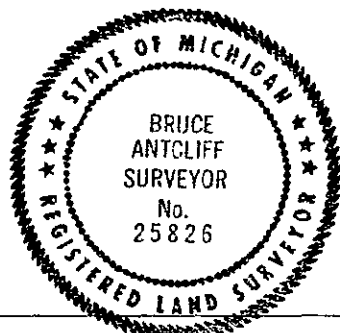

900 FILE
200

MAP L. 1589

SECTION

LIBER 19296PC588

A. Description of original monument and accessories and/or subsequent restoration:

F-7	1989	McNeely	Survey	N/A
	1990	Green	Survey	N/A
	1991	Brady	Survey	N/A
	1991	McNeely	Survey	N/A
	1991	Kostecke	Cert. Survey L. 11855 P. 168	Iron
	1991	Kostecke	Survey	Iron
	N/A	N/A	O.C. Tax Maps	N/A