

RECORDATION SECTION

LIBER 19296PG589

1899

LAND CORNER RECORDATION CERTIFICATE
Filing Requirement of Act 74, Mich. P.A. 1970

For corners in SECTION


Table with columns: County (Oakland), Located in: Lyon Township, Corner Code # (F-9), and survey details (Public Land Survey, Property Controlling, etc.)

\$ 7.00 MISCELLANEOUS RECORDING
\$ 2.00 REMONUMENTATION
17 DEC 98 3:36 P.M. RECEIPT# 51B
PAID RECORDED - OAKLAND COUNTY
G. WILLIAM CADDELL
CLERK/REGISTER OF DEEDS

Compliance with ACT 345, P.A. 1990
APPROVED ON: 11-10-98 JS
OAKLAND COUNTY REMONUMENTATION PEER GROUP COMMITTEE
Register of Deeds Stamp & File Number

- 4. Lot No. Recorded Plat
5. Private Claims

I, Bruce Antcliff, in a field survey on June 18, 1998, do hereby certify that under requirements of P.A. 74 Michigan P.A. of 1970, the corner points mentioned in lines 1 and 2 above were in conformance with regulations and rules therefore as required in the current manual of survey instructions of the United States Department of the interior, Bureau of Land Management or by a decree of a Court of Law and/or that the corner points mentioned in lines 3, 4 and 5 above were in conformance with the rules of the Michigan Board of Land Surveyors or by a Decree of a Court of Law; established, re-established, monumented, re-monumented, recovered, found as expressed below:

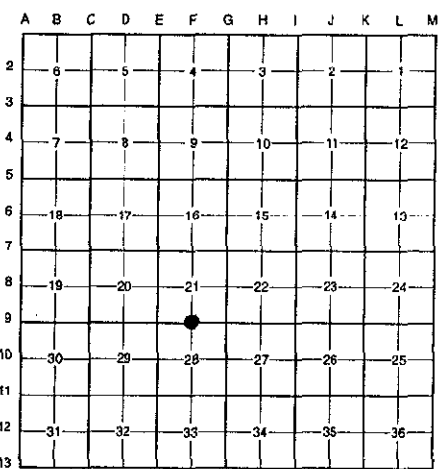

NOTE: Not more than 4 corners, all in the same town and range, may be recorded on this certificate.

A. Description of original monument and accessories and/or subsequent restoration:

Table with columns: F-9, Year, Name, Description, and Monument Type (Set Post, Stone, PK Spike, etc.)

B. Description of corner evidence found and/or method applied in restoring or reestablishing corner:

F-9 Found a 1/2" iron in a monument box .5' North of the C/L of 10 Mile Road (bit.) running East and West on line of a tree row running North and South. The found iron in a monument box checks surveys and L.C.R.C.'s from 1971 to the present. Also checks the following witnesses:

- L.C.R.C. L. 5771 P. 774 (1971) S 25° E 30.2' 24" Maple SP C/L W/S (m. 30.08')
Cert. Survey L. 8313 P. 572 (1982) S 25° E 30.2' 24" Maple SP C/L W/S (m. 30.08')
N 30° W 35.71' 24" Maple SP C/L E/S (m. 36.24') N 30° W 35.71' 24" Maple SP C/L E/S (m. 36.24')
South 33' 1/2" x 18" Iron Rerod South 33' 1/2" x 18" Iron Rerod (m. 33.01')

Measure East 2608.5' to G-9 (G.L.O. = 2656.5') (Kostecke Survey (1972) = 2609.60') (Boss Survey (1991) = 2608.54') (O.C. Tax Maps = 2608.0')
Measure West 2645.2' to E-9 (G.L.O. = 2656.5') (Newman Survey (1995) = 2645.60')

C. Description of monument for corner and accessories established to perpetuate locating the position of the corner:

F-9 Replaced 1/2" iron in a monument box with a 5/8" x 24" rebar with brass cap stamped "Oakland County Remonumentation P.S. #25826" in an existing monument box.

- PK Nail & Oakland Co. Remonumentation Tag in W Side 24" Maple S 25° E 30.08'
PK Nail & Oakland Co. Remonumentation Tag in W Side 30" Walnut N 30° W 36.24'
PK Nail & Oakland Co. Remonumentation Tag in W Side P. Pole North 30.70'
PK Nail & Oakland Co. Remonumentation Tag in NW'ly Side 10" Ash S 60° W 59.74'
PK Nail & Oakland Co. Remonumentation Tag in E'ly Side 30" Maple S 45° E 43.81'
1/2" Iron Pipe South 33.01'

The selected location is accepted by the Contractor and is generally accepted by professional surveyors as the best available evidence of the position of the original corner.

Signed by Bruce Antcliff Date 12-10-98

EARTH TECH
Surveyor's Michigan License No. 25826



700 FILE
200