

LAND CORNER RECORDATION CERTIFICATE
Filing Requirement of Act 74, Mich. P.A. 1970


For corners in

Table with columns: Oakland (County), Located in: Lyon Township, Corner Code #. Rows include Public Land Survey, Property Controlling in Section, and Miscellaneous Property in Sec.

\$ 7.00 MISCELLANEOUS RECORDING
\$ 2.00 REMONUMENTATION
17 DEC 98 3:36 P.M. RECEIPT # 118
PAID RECORDED - OAKLAND COUNTY
G. WILLIAM CADDELL
CLERK/REGISTRAR OF DEEDS
ACT 345, P.A. 1990
APPROVED ON: 11-10-98 55
OAKLAND COUNTY REMONUMENTATION
PEER GROUP COMMITTEE
Register of Deeds Stamp & File Number

4. Lot No. _____, Recorded Plat _____
5. Private Claims _____

I, Bruce Antcliff, in a field survey on February 28, 1998, do hereby certify that under requirements of P.A. 74 Michigan P.A. of 1970, the corner points mentioned in lines 1 and 2 above were in conformance with regulations and rules therefore as required in the current manual of survey instructions of the United States Department of the interior, Bureau of Land Management or by a decree of a Court of Law and/or that the corner points mentioned in lines 3, 4 and 5 above were in conformance with the rules of the Michigan Board of Land Surveyors or by a Decree of a Court of Law; established, re-established, monumented, re-monumented, recovered, found as expressed below:

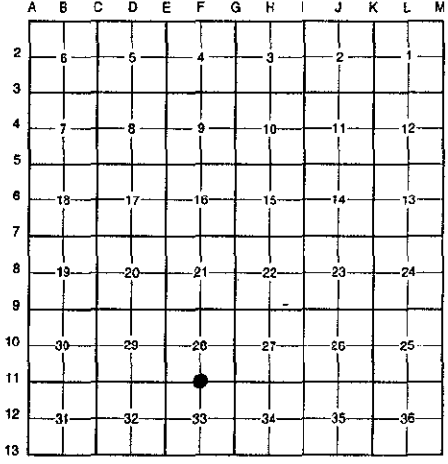

NOTE: Not more than 4 corners, all in the same town and range, may be recorded on this certificate.

Table A: Description of original monument and accessories and/or subsequent restoration. Columns: F-11, 1816, Holmes, G.L.O., 1973, Green, Survey, Set Post, 1973, Green, Survey, N/A, 1990, Tietsema, Survey, 1" Iron Pipe, N/A, N/A, O.C. Tax Maps, N/A.

B. Description of corner evidence found and/or method applied in restoring or reestablishing corner:
F-11 Found a 1" iron pipe 7' South of the South edge of 9 Mile Road (gravel) running East and West, on line of a fence row running South and 10' East of a tree row running North. The found 1" iron is at the midpoint between E-11 and G-11 0.1' +/- Checks witnesses in unrecorded Tietsema survey from 1990. Also checks the following witnesses:

- Unrecorded Survey (1990)
S 10° W 10.54' 40" Maple (m. 9.60')
N 50° W 63.10' 20" Maple (m. 63.32')
N 20° W 45.19' 12" Maple (m. 45.80')

Measure East 2657.2' to G-11 (G.L.O. = 2673.0')
Measure West 2657.1' to E-11 (G.L.O. = 2673.0')

C. Description of monument for corner and accessories established to perpetuate locating the position of the corner:
F-11 Replaced the 1" iron pipe with a 4" x 36" concrete monument with brass cap stamped "Oakland County Remonumentation P.S. #25826."
PK Nail & Oakland Co. Remonumentation Tag in E Side 40" Maple S 30° W 9.60'
PK Nail & Oakland Co. Remonumentation Tag in SW Side 22" Maple N 50° W 63.32'
PK Nail & Oakland Co. Remonumentation Tag in E Side 12" Maple N 20° W 45.80'
PK Nail & Oakland Co. Remonumentation Tag in NE Cor. 5 x 3 Wood Fence Post S 21° E 48.40'

The selected location is accepted by the Contractor and is generally accepted by professional surveyors as the best available evidence of the position of the original corner.

Signed by Bruce Antcliff Date 12-10-98
EARTH TECH
Surveyor's Michigan License No. 25826

