

RECORDATION SECTION

LIBER 19350PC900

1JA-599001694

MAR 11 1999

LAND CORNER RECORDATION CERTIFICATE
Filing Requirement of Act 74, Mich. P.A. 1970

\$ 7.00 MISCELLANEOUS RECORDING
\$ 2.00 REMONUMENTATION
5 JAN 99 8:28 A.M. RECEIPT# 8A
FILED - OAKLAND COUNTY
RECORDATION SECTION

For corners in SECTION
Oakland (County)


Located in: Lyon Township
Corner Code #

- 1. Public Land Survey T 1N R 7E G-6
2. Property Controlling in Section S T R
3. Miscellaneous Property in Sec. S T R

Compliance with ACT 345, P.A. 1990
APPROVED ON: 12-16-98 53
OAKLAND COUNTY REMONUMENTATION PEER GROUP COMMITTEE
Register of Deeds Stamp & File Number

- 4. Lot No. Recorded Plat
5. Private Claims

I, Bruce Antcliff, in a field survey on November 4 19 98, do hereby certify that under requirements of P.A. 74 Michigan P.A. of 1970, the corner points mentioned in lines 1 and 2 above were in conformance with regulations and rules therefore as required in the current manual of survey instructions of the United States Department of the interior, Bureau of Land Management or by a decree of a Court of Law and/or that the corner points mentioned in lines 3, 4 and 5 above were in conformance with the rules of the Michigan Board of Land Surveyors or by a Decree of a Court of Law; established, re-established, monumented, re-monumented, recovered, found as expressed below:

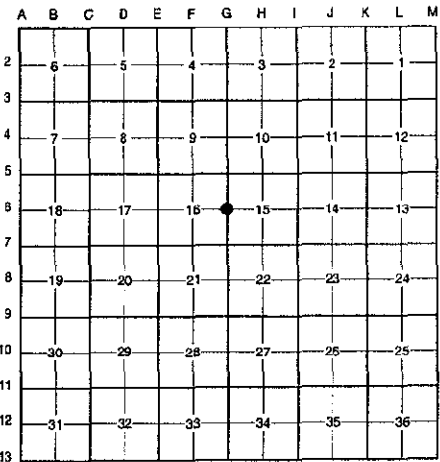

NOTE: Not more than 4 corners, all in the same town and range, may be recorded on this certificate.

A. Description of original monument and accessories and/or subsequent restoration:

Table with 4 columns: G-6, Date, Name, Description, and Monument Type. Rows include entries for 1816, 1966, 1979, 1990, 1994, and N/A.

B. Description of corner evidence found and/or method applied in restoring or reestablishing corner:

G-6 The 2" iron and all witnesses shown in L.C.R.C. L. 7700 P. 770 have been destroyed. Using concrete plat monument at the Southeast corner of Lyon Commons, a found iron in the C/L of Spaulding Road, and concrete plat monuments at the Southwest and Southeast corners of Helfer Subdivision, extended line East and set corner at Record dist. (1317.88') East of 1/2" iron in the C/L of Spaulding Drive per Lyon Commons Sub.

700 FILE
200


Measure North 2645.8' to G-5 (G.L.O. = 2640.0') (Washtenaw Eng. Survey (1994) = 2642.85')
Measure South 2637.1' to G-7 (G.L.O. = 2640.0')

C. Description of monument for corner and accessories established to perpetuate locating the position of the corner:

G-6 Replaced the capped rebar with a 5/8" x 24" rebar with brass cap stamped "Oakland County Remonumentation P.S. #25826."

- PK Nail & Oakland Co. Remonumentation Tag in SE side 30" Oak N 30° W 57.58'
PK Nail & Oakland Co. Remonumentation Tag in N side 18" Oak S 45° E 32.82'
PK Nail & Oakland Co. Remonumentation Tag in E side 18" Oak S 10° W 32.15'
PK Nail & Oakland Co. Remonumentation Tag in NE side 18" Oak S 45° W 55.93'

The selected location is accepted by the Contractor and is generally accepted by professional surveyors as the best available evidence of the position of the original corner.

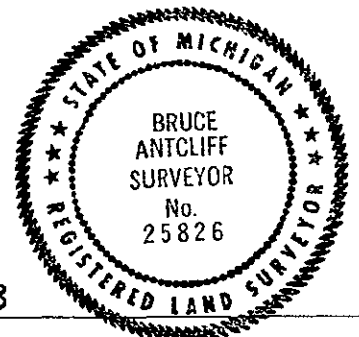

Signed by Bruce Antcliff Date 12-22-98
EARTH TECH

Surveyor's Michigan License No. 25826