

MAR 11 1999

LIBER 19296PG595

LAND CORNER RECORDATION CERTIFICATE
Filing Requirement of Act 74, Mich. P.A. 1970

For corners in SECTION

Form with fields for County (Oakland), Township (Lyon), Corner Code # (G-7), and survey types (Public Land Survey, Property Controlling, etc.)

Stamp area containing recording fees (\$9.00 MISCELLANEOUS RECORDING, \$2.00 REMONUMENTATION), date (17 DEC 98), and official signatures (G. WILLIAM CADDELL, CLERK/REGISTER OF DEEDS).

4. Lot No. , Recorded Plat
5. Private Claims

I, Bruce Antcliff, in a field survey on June 15 19 98, do hereby certify that under requirements of P.A. 74 Michigan P.A. of 1970, the corner points mentioned in lines 1 and 2 above were in conformance with regulations and rules therefore as required in the current manual of survey instructions of the United States Department of the Interior, Bureau of Land Management or by a decree of a Court of Law and/or that the corner points mentioned in lines 3, 4 and 5 above were in conformance with the rules of the Michigan Board of Land Surveyors or by a Decree of a Court of Law; established, re-established, monumented, re-monumented, recovered, found as expressed below:

NOTE: Not more than 4 corners, all in the same town and range, may be recorded on this certificate.

A. Description of original monument and accessories and/or subsequent restoration:

G-7 1816 Holmes G.L.O. Set Post
N/A American Eng. Survey N/A
1969 N/A Survey N/A

(Continued on Back)

B. Description of corner evidence found and/or method applied in restoring or reestablishing corner:

G-7 Found a railroad spike in a monument box 6.80' East of the C/L of Milford Road (bit.) running North and South, 5' +/- North of the C/L of 11 Mile gravel) running West and 23' +/- North of the C/L of 11 Mile Road (gravel) running East. The found railroad spike in a monument box checks surveys and L.C.R.C.'s from 1973 to the present. Also checks the following witnesses:

L.C.R.C. L. 16280 P. 594 (1996)
S 40° W 58.20' 3" Fence Post (m. 58.25')
N 40° W 57.95' N Side Sign Post (m. 57.78')
N30° E 42.32' SW Cor. Bell Box (m. 42.33')
N 55° E 65.92' PK Nail & Tag in S Side U.P. (m. 65.92')

Cert. Survey L. 7728 P. 33 (1980)
NW 57.8' Street sign Post (m. 57.78')

Measure North 2637.1' to G-6 (G.L.O. = 2640.0')
Measure South 2640.1' to G-8 (G.L.O. = 2640.0')(Alix Survey (1977) = 2640.02') (O.C. Tax Map = 2639.60')
Measure East 2638.52' to H-7 (G.L.O. = 2643.30') (Kostecke Survey (1973) = 2639.28') (Kostecke Survey (1980) = 2638.44')
(Kostecke Survey (1995) = 2638.54') (O.C. Tax Map = 2639.28')
Measure West 2635.38' to F-7 (G.L.O. = 2638.68')

C. Description of monument for corner and accessories established to perpetuate locating the position of the corner:

G-7 Replaced railroad spike in a monument box with a 5/8" x 24" rebar with brass cap stamped "Oakland County Remonumentation P.S. #25826" in an existing monument box.



3" Fence Post at Base of Pole S 40° W 58.25'
North Side Street Sign Post N 40° W 57.78'
SW Cor. Bottom Bell Box (MBT) N 30° E 42.33'
PK Nail & Oakland Co. Remonumentation Tag in S Side Util. Pole N 55° E 65.92'

The selected location is accepted by the Contractor and is generally accepted by professional surveyors as the best available evidence of the position of the original corner.

Signed by Bruce Antcliff
EARTH TECH

Date 12-10-98

Surveyor's Michigan License No. 25826

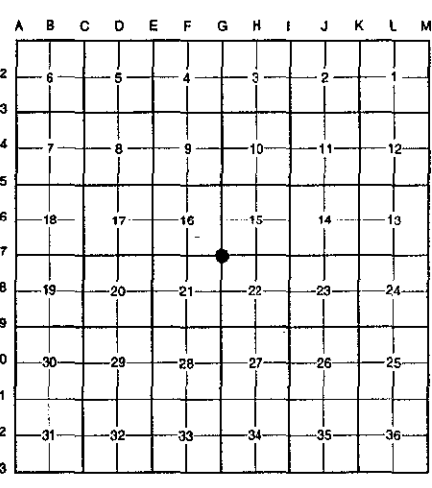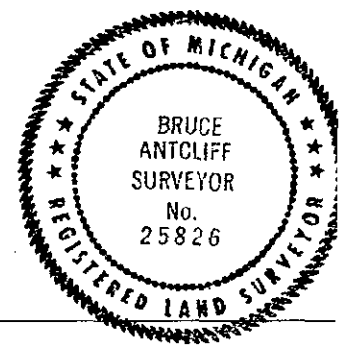

Handwritten note: 9.00 FILE 2.00

RECORD

SECTION

19296PC596

SECTION

A. Description of original monument and accessories and/or subsequent restoration:

G-7	1973	Kostecke	Boundary Survey	Mon. Box
	1977	N/A	Cert. Survey L. 7065 P. 382	N/A
	1979	Kostecke	Cert. Survey L. 7592 P. 829	N/A
	1980	Kostecke	Cert. Survey L. 7728 P. 33	R.R. Spike
	1988	Kostecke	Survey	Mon. Box
	1995	Kostecke	Survey	N/A
	1996	Bailey	L.C.R.C. L. 16280 P. 594	R.R. Spike in Mon. Box
	N/A	N/A	O.C. Tax Maps	N/A