

1999

LIBER 19296PG599

LAND CORNER RECORDATION CERTIFICATE  
Filing Requirement of Act 74, Mich. P.A. 1970

For corners in

SECTION

<u>Oakland</u> (County)	Located in: Lyon Township	Corner Code #
1. Public Land Survey	T <u>1N</u> R <u>7E</u>	<u>G-9</u>
	T _____ R _____	_____
	T _____ R _____	_____
	T _____ R _____	_____
2. Property Controlling in Section	S _____ T _____ R _____	_____
	S _____ T _____ R _____	_____
3. Miscellaneous Property in Sec.	S _____ T _____ R _____	_____
	S _____ T _____ R _____	_____
4. Lot No. _____, Recorded Plat _____		
5. Private Claims _____		

\$ 9.00 MISCELLANEOUS RECORDING  
 \$ 2.00 REMONUMENTATION  
 17 DEC 98 3:57 P.M. RECEIPT# 518  
 PAID RECORDED - OAKLAND COUNTY  
 G. WILLIAM CADDELL  
 CLERK/REGISTER OF DEEDS  
 ACT 345, P.A. 1990  
 APPROVED ON: 11-24-98 55  
 OAKLAND COUNTY REMONUMENTATION  
 PEER GROUP COMMITTEE  
 Register of Deeds Stamp & File Number

I, Bruce Antcliff, in a field survey on June 18 19 98, do hereby certify that under requirements of P.A. 74 Michigan P.A. of 1970, the corner points mentioned in lines 1 and 2 above were in conformance with regulations and rules therefore as required in the current manual of survey instructions of the United States Department of the Interior, Bureau of Land Management or by a decree of a Court of Law and/or that the corner points mentioned in lines 3, 4 and 5 above were in conformance with the rules of the Michigan Board of Land Surveyors or by a Decree of a Court of Law; established, re-established, monumented, re-monumented, recovered, found as expressed below:

NOTE: Not more than 4 corners, all in the same town and range, may be recorded on this certificate.

A. Description of original monument and accessories and/or subsequent restoration:

G-9	1816	Holmes	G.L.O.	Set Post
	1974	McKeever	Cert. Survey L. 6536 P. 187	Rerod In Mon. Box
	1976	Postiff	L.C.R.C. L. 6709 P. 529	Fnd. Mon. Box In Asphalt Paving

(Continued on Back)

B. Description of corner evidence found and/or method applied in restoring or reestablishing corner:

G-9 Found an iron in a monument box on the C/L intersection of 10 Mile Road (bit.) running East and West and Milford Road (bit.) running North. The found iron checks surveys and L.C.R.C.'s from 1976 to the present. Also checks the following witnesses:

L.C.R.C. L. 6709 P. 529 (1976) SE 80.94' PK NE Face D.E. Pole (m. 82.30')	Unrecorded Survey (1985) N 45° W 59.35' to Nail in Power Pole (m. 59.08') N 45° E 67.54' to Nail in Power Pole (m. 67.64') S 45° E 80.78' to Nail in Power Pole (m. 82.30')
--	--

900 FILL  
200

Measure North 2637.5' to G-8 (G.L.O. = 2640.0') (Boss Survey (1980) = 2636.74') (Ross Surveys (1986 & 1993) = 2637.55')  
 Measure South 2633.4' to G-10 (G.L.O. = 2640.0') (Boss Survey (1991) = 2633.46')  
 Measure East 2628.0' to F-9 (G.L.O. = 2639.34') (Boss Survey (1991) = 2628.00') (Smith Survey (1994) = 2628.09')  
 Measure West 2608.5' to H-9 (G.L.O. = 2656.5') (Kostecke Survey (1972) = 2609.60') (Boss Survey (1991) = 2608.54')


C. Description of monument for corner and accessories established to perpetuate locating the position of the corner:

G-9 Replaced iron with a 5/8" x 24" rebar with brass cap stamped "Oakland County Remonumentation P.S. #25826" in an existing monument box.

PK Nail & Oakland Co. Remonumentation Tag in P. Pole S 45° E 82.30'  
 PK Nail & Oakland Co. Remonumentation Tag in P. Pole N 45° E 67.64'  
 PK Nail & Oakland Co. Remonumentation Tag in NW Side 2.5' High Wood Post S 40° W 27.38'  
 PK Nail & Oakland Co. Remonumentation Tag in E'ly Side P. Pole N 45° W 59.08'

The selected location is accepted by the Contractor and is generally accepted by professional surveyors as the best available evidence of the position of the original corner.

Signed by Bruce Antcliff Date 12-10-98  
 EARTH TECH  
 Surveyor's Michigan License No. 25826

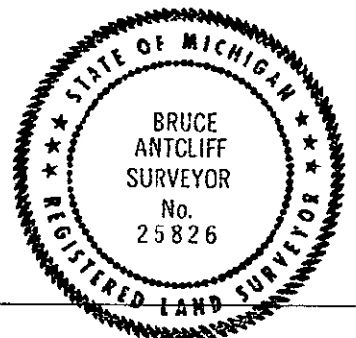

QUINCY  
RECORDS SECTION

1999

TIBER 19296PC600

SECTION

A. Description of original monument and accessories and/or subsequent restoration:

G-9	1976	Postiff	Cert. Survey L. 6709 P. 530	Fnd. Mon. Box in Asphalt Paving
	1980	G. Boss	Cert. Survey L. 7844 P. 87	N/A
	1985	Washtenaw Eng.	Survey	N/A
	1991	G. Boss	Cert. Survey L. 11887 P. 289	N/A
	1991	G. Boss	Cert. Survey L. 11825 P. 461	N/A
	1993	Thompson	Cert. Survey L. 14484 P. 067	1" Iron
	1993	Thompson	Cert. Survey L. 14087 P. 270	1" Iron
	N/A	N/A	O.C. Tax Maps	N/A